

JACKSON MISSISSIPPI BOARD OF WATER COMMISSIONERS

WATER WELL DRILLERS LOG

3-10-64

Date: 3-10, 1964, Driller: *Art. W. Walker County Jackson*

(Name)

(1) Owner of land: *Joe R. Walker, Jr.*

(Name)

(Address) *406 1/2 Baker St. Biola*

(2) Location: *NW 1/4, S 1/4, Sec. 12 T 75R 6 W*

(distance) *N* of *Hampton* (direction) (Nearest Town)

(3) Topography: *Rolling* (Hilly) (Flat) (Level)

(4) Purpose of Well: *Domestic* (Domestic Irrigation, Industrial, Other)

Information upon completion of well:

(1) Diameter: *4* inches.

(2) Total Depth: *273* feet.

(3) Water Level: *8* feet below top of ground.

(4) Cased to: *000* Size: *4"*

(5) Screen: Size: *4"* Length: *20'*

(6) Were any formations sealed against pollution? Yes, no.

If YES depth of formation

Why

Drillers Remarks:

Well No.	(Use Back Side)
30	Clay
30	Clay
24	Clay
52	Clay
157	Clay
62	Clay
273	Clay

Description & Color of Materials
Sand, Clay, Red Clay, Shell, etc.

Depth

Thick-
ness
Feet

30

30


24

52

157

62

273

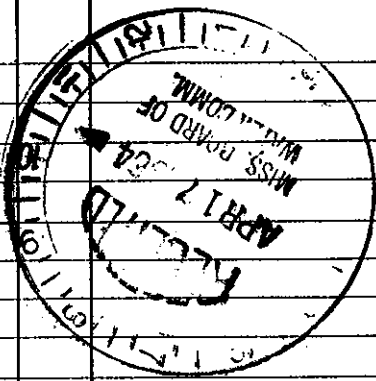

all this copy to Board of Water Commissioners 429 Miss. St. Jackson, Miss.