

~~2108~~

Q P 79
7-8-60

V 96.5

WATER WELL DRILLERS LOG

Colville Water

Date: 7-8, 1960, Driller: Supply Co County: JACKSON

(Name)

(1) Owner of Land: Clark Seafood Co
(Name)

Pascagoula Miss
(Address)

(2) Location: 1/4, 1/4, Sec. T R S
irregular 75 R 54

1/4 N-Hwy 90 and 1/4 W of Pascagoula
(distance) (direction) (Nearest Town)

(3) Topography: (Hilly) (Flat) (Level) ✓

(4) Purpose of Well: Industrial
(Domestic Irrigation, Municipal, Industrial, Other)

Information upon completion of well:


- (1) Diameter 3 inches.
- (2) Total Depth 294 feet.
- (3) Water Level 36.5 feet below top of ground.
- (4) Cased to none, Size _____
- (5) Screen: Size 3", Length 15'
- (6) Were any formations sealed against pollution?
yes, no. ✓

If YES depth of formation _____

Why _____

Drillers Remarks: _____

Description & Color of Materials Sand, Clay, Red Clay, Shell, etc.	Thick- ness Feet	Depth Feet
0 to 204 SAND gray		
204 - 206 BLUE Mud		
206 - 210 gray SAND		
210 - 220 STICKS SAND AND Mud		
220 to 231 SAND		
231 to 252 SAND		
252 - 273 SAND		
273 - 294 SAND		
TD 294		

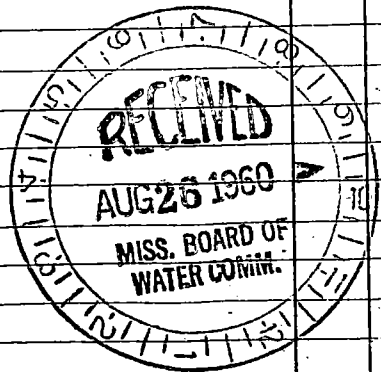

(Use Back Side)

YTH:

1940
1941

A vertical grid structure consisting of multiple columns and rows, resembling a ledger or form template. The grid is oriented vertically on the page. It has approximately 10 columns and 20 rows. The top few rows contain some faint markings and numbers, but the rest of the grid is mostly empty.