

USES

PI47
10-9-61

WATER WELL DRILLERS LOG

Date: Oct 9, 1961, Driller: Colville County Jackson
(Name)

(1) Owner of Land Continental Can Co.
(Name)
Pascagoula
(Address)

(2) Location: NE 1/4, SW 1/4, Sec. 1 T25R6E
(distance) (direction) (Nearest Town)

(3) Topography: Flat
(Hilly) (Flat) (Level)

(4) Purpose of Well: Industrial
(Domestic Irrigation
Municipal, Industrial, Other)

Description & Color of Materials Sand, Clay, Red Clay, Shell, etc.	Thick- ness Feet	Depth Feet
Fill Dirt		10
Blue Mud	45	55
Sand	120	175
Clay	98	273
Sand	21	294
		T.D.

Information upon completion of well:

(1) Diameter 4 inches.

(2) Total Depth 294 feet.

(3) Water Level 58'6" feet below top of ground.

(4) Cased to _____, Size _____.


(5) Screen: Size 4", Length 20'.

(6) Were any formations sealed against pollution?
_____ yes, _____ no.

If YES depth of formation _____

Why _____

Drillers Remarks: _____

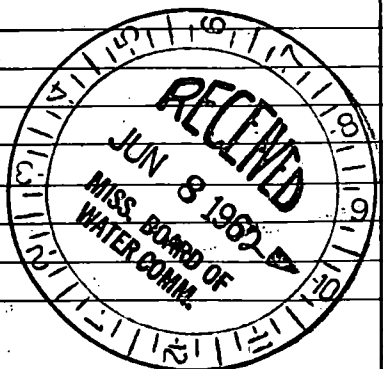

(Use Back Side)

Well No. 75

