

P 166
4-14-64

WATER WELL DRILLERS LOG

Date: 4-14-64 ¹⁹~~64~~, Driller: Layne-Central Co. County Jackson

(Name)

(1) Owner of Land: Quaker Oats Co.

(Name)

Pascagoula, Miss.

(Address)

(2) Location: 1/4, 1/4, Sec. 5 ^{5 W} T7 R8

_____ miles in of Pascagoula
(distance) (direction) (Nearest Town)

(3) Topography:

(Hilly) (Flat) (Level)

(4) Purpose of Well: Industrial

(Domestic Irrigation
Municipal, Industrial, Other)

Description & Color of Materials
Sand, Clay, Red Clay, Shell, etc.

Thick-
ness
Feet

Depth
Feet

shell	2	2
sandy clay	4	6
blue clay	14	20
fine sand st. clay	50	70
coarse white sand	30	100
blue clay	56	156
stks sand, clay, shell	50	186
st. sand and clay	24	210
fine gummy sand	58	268
medium sand	56	324
clay	3	327

Information upon completion of well:

(1) Diameter 12 inches.

(2) Total Depth 326 feet.

(3) Water Level 48 feet below top of ground.

(4) Cased to 264', Size 8"

(5) Screen: Size 8", Length 50'


(6) Were any formations sealed against pollution?

X yes, _____ no.

If YES depth of formation required

Why _____

Drillers Remarks: _____

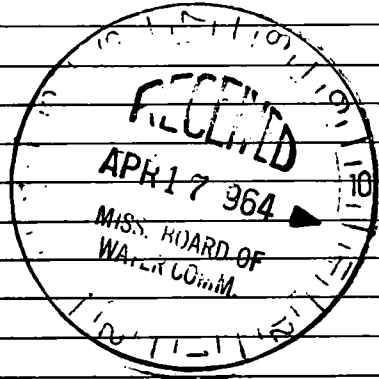

(Use Back Side)

Well No.

