

# JACKSON MISSISSIPPI BOARD OF WATER COMMISSIONERS

P167

9-8-62

## WATER WELL DRILLERS LOG

Date: Sept 8, 1962, Driller: Andrew Colville County Jackson

(Name)

(1) Owner of Land	Description & Color of Materials Sand, Clay, Red Clay, Shell, etc.	Thick- ness Feet	Depth Feet
<u>Thomas Roberts</u> (Name)	<u>0-21 clay</u>		
<u>Gautier, Miss</u> (Address)	<u>21-40 Red sand</u>		
(2) Location: <u>Ingraham Sect 31</u>	<u>40-50 Sand</u>		
<u>1</u> miles <u>west</u> of <u>Gautier</u>	<u>50-63 sand</u>		
(distance) (direction) (Nearest Town)	<u>63-68 sand</u>		
(3) Topography: <u>Flat</u>	T.P.		
(Hilly) (Flat) (Level)			
(4) Purpose of Well: <u>Domestic</u>			
(Domestic Irrigation Municipal, Industrial, Other)			

### Information upon completion of well:

(1) Diameter 1 1/4 inches.

(2) Total Depth 68 feet.

(3) Water Level 13'6" feet below top of ground.

(4) Cased to \_\_\_\_\_, Size \_\_\_\_\_.


(5) Screen: Size 1 1/4, Length 5'.

(6) Were any formations sealed against pollution?  
 \_\_\_\_\_ yes, X no.

If YES depth of formation \_\_\_\_\_

Why \_\_\_\_\_

Drillers Remarks: \_\_\_\_\_

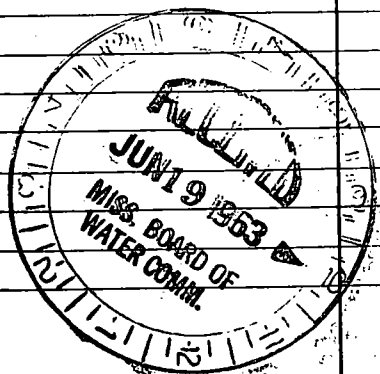

Well No.  
173

