

P 170

WATER WELL DRILLERS LOG

4-13-61

COLVILLE

Date: 4/13, 1961, Driller: Water Supply Co County JACKSON

4 P

(1) Owner of Log: J. J. Rogers (Name) Eseatampa Miss (Address)

(2) Location: SW 1/4, SW 1/4, Sec 12 T7S R6W (distance) (direction) (Nearest Town)

(3) Topography: (Hilly) (Flat) (Level) [checked]

(4) Purpose of Well: [checked] Domestic Irrigation Municipal, Industrial, Other

Description & Color of Materials Sand, Clay, Red Clay, Shell, etc.	Thick- ness Feet	Depth Feet
0 CLAY 16		SAND
76 SAND 84		SAND
120 CLAY 147		SAND
184 CLAY 273		SAND
345 720		

Depth FORM depth FORM

W Level 6'

Information upon completion of well:

(1) Diameter 2 inches.

(2) Total Depth 345 feet.

(3) Water Level 6' feet below top of ground.

(4) Cased to \_\_\_\_\_, Size \_\_\_\_\_


(5) Screen: Size 2", Length 10'

(6) Were any formations sealed against pollution? \_\_\_\_\_ yes, \_\_\_\_\_ no.

If YES depth of formation \_\_\_\_\_

Why \_\_\_\_\_

Drillers Remarks: \_\_\_\_\_

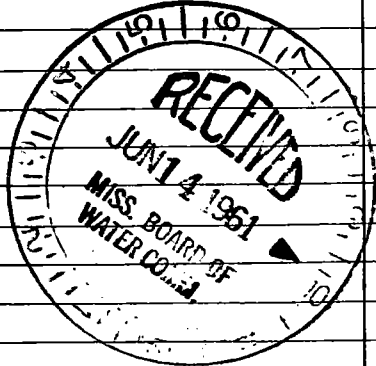

(Use Back Side)

Well No. 40

