

P 305

P 172
4-17-61

WATER WELL DRILLERS LOG

Date: 4/17, 1961 Driller: Water Supply Co County JACKSON
49 61 (Name)

(1) Owner of Land C.T. Cooley
(Name)
Escatawpa Miss
(Address)

(2) Location SW 1/4 NW 1/4, Sec. 1 T7S R6 E4
_____ miles _____ of _____
(distance) (direction) (Nearest Town)

(3) Topography: _____
(Hilly) (Flat) (Level)

(4) Purpose of Well: _____
 (Domestic Irrigation
Municipal, Industrial, Other)

Description & Color of Materials Sand, Clay, Red Clay, Shell, etc.	Thick- ness Feet	Depth Feet

Information upon completion of well:

(1) Diameter 1 1/4 inches.

(2) Total Depth 367 feet.

(3) Water Level + 1' feet below top of ground.

(4) Cased to _____, Size _____

(5) Screen: Size 1 1/4, Length 10'

(6) Were any formations sealed against pollution?

_____ yes, _____ no.

If YES depth of formation _____

Why _____

Drillers Remarks: _____


This well flows
just a little

depth FORM depth FORM

0 CLAY 63 gravel + sand
100 sand + clay 126 CLAY
182 sand 231 CLAY
347 sand 367

JR 367

Water Level
+ 1'

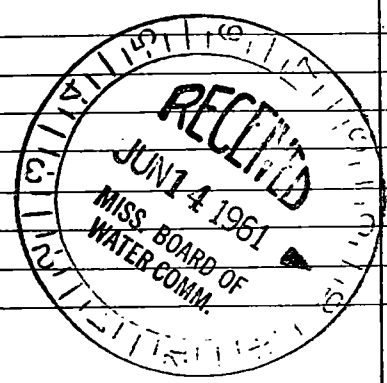

(Use Back Side)

Well No. 41

[Faint, illegible handwritten text, possibly bleed-through from the reverse side of the page]