

JACKSON MISSISSIPPI BOARD OF WATER COMMISSIONERS

P 309

P 177
6-5-61

WATER WELL DRILLERS LOG
COLVILLE

Date: 6/5, 1961, Driller: Water Supply Co County: JACKSON

59

(1) Owner of Land:	Description & Color of Materials Sand, Clay, Red Clay, Shell, etc.	Thick- ness Feet	Depth Feet
(Name) <u>Robertson Hardware</u> (Address) <u>R 7th Pascagoula Hwy</u>			
(2) Location: <u>SW 1/4, SW 1/4, Sec 36 T8R6N</u> <u>1/2 miles East</u> of <u>Pascagoula</u> (distance) (direction) (Nearest Town)			
(3) Topography: _____ (Hilly) (Flat) (Level) <input checked="" type="checkbox"/>	<u>Depth 90YM</u>	<u>Depth 70YM</u>	
(4) Purpose of Well: _____ (Domestic Irrigation <input checked="" type="checkbox"/> Municipal, Industrial, Other)	<u>0 clay 37 Sand</u> <u>63 Gravel 73 I.D.</u>		


Information upon completion of well:

- (1) Diameter 2 inches.
- (2) Total Depth 73 feet.
- (3) Water Level 10' feet below top of ground.
- (4) Cased to _____, Size _____
- (5) Screen: Size 2", Length 10'
- (6) Were any formations sealed against pollution?
 _____ yes, _____ no.

If YES depth of formation _____
 Why _____
 Drillers Remarks: _____

Description & Color of Materials Sand, Clay, Red Clay, Shell, etc.	Thick- ness Feet	Depth Feet
<u>0 clay 37 Sand</u> <u>63 Gravel 73 I.D.</u>		

water level
10'

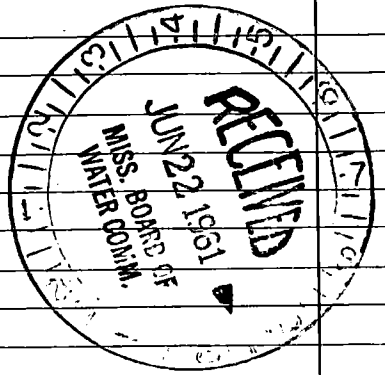

(Use Back Side)

Well No. 59

0