

JACKSON MISSISSIPPI BOARD OF WATER COMMISSIONERS

P 181

9-14-61

WATER WELL DRILLERS LOG

Date: Sept 14, 1961, Driller: Colville County Jackson
(Name)

(1) Owner of Land: Vernon Cropp
(Name)

Escatawpa, Miss.
(Address)

(2) Location: NW 1/4, NE 1/4, Sec. 9 T28R6W
(distance) (direction) (Nearest Town)

(3) Topography: Level
(Hilly) (Flat) (Level)

(4) Purpose of Well: Domestic
(Domestic Irrigation) (Municipal, Industrial, Other)

Description & Color of Materials Sand, Clay, Red Clay, Shell, etc.	Thick- ness Feet	Depth Feet
slush	15	0
clay	21	
sand & clay stks	42	
sandy clay	63	
sand	80	
clay	94	
sand	155	
clay	168	
sand	182	
clay	189	
sand & clay stks	273	
sand	283	
	304	TD

Information upon completion of well:

(1) Diameter 1 1/4 inches.

(2) Total Depth 304 feet.

(3) Water Level 7' 6" feet below top of ground.

(4) Cased to _____, Size _____

(5) Screen: Size 1 1/4, Length 10'


(6) Were any formations sealed against pollution?

_____ yes, no.

If YES depth of formation _____

Why _____

Drillers Remarks: _____

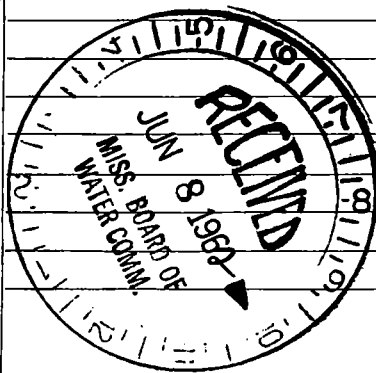

(Use Back Side)

Well No. 72

