

P 182
9-18-61

WATER WELL DRILLERS LOG

Date: Sept 14, 1961, Driller: Calville County Jackson
49 (Name)


(1) Owner of Land: P.W. Durham
(Name)
Escatawpa
(Address)
(2) Location: SE 1/4, SW 1/4, Sec. 1 75 (NW)
1 miles North, of Escatawpa
(distance) (direction) (Nearest Town)
(3) Topography: Flat
(Hilly) (Flat) (Level)
(4) Purpose of Well: Domestic
(Domestic Irrigation
Municipal, Industrial, Other)

Description & Color of Materials Sand, Clay, Red Clay, Shell, etc.	Thick- ness Feet	Depth Feet
Slush		5
Mud	37	42
Sand	38	80
Clay	25	105
Sand	11	116
Clay	15	126
Sand	14	140
Clay	7	147
Sand	11	158
Clay	136	294
Fine Sand	5	299
Clay	76	375
Sand	6	381
Clay	291	672
Sand	15	687
		T.D.

Information upon completion of well:

(1) Diameter 1 1/4 inches.
(2) Total Depth 687 feet.
(3) Water Level +7' feet below top of ground.
(4) Cased to _____, Size _____
(5) Screen: Size 1/4, Length 15'
(6) Were any formations sealed against pollution?
_____ yes, no.

If YES depth of formation _____
Why _____
Drillers Remarks: _____

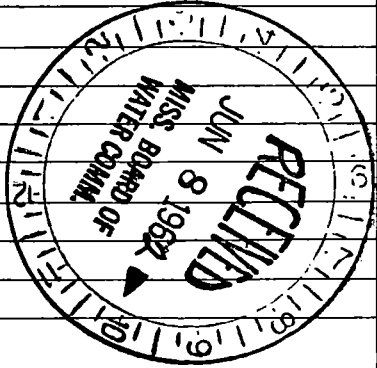

(Use Back Side)

Well No. 88

