

JACKSON MISSISSIPPI BOARD OF WATER COMMISSIONERS

49' sand

P 188
1-30-62

WATER WELL DRILLERS LOG

Date: 1-30, 1962, Driller: Sutter Well Works County Jackson

(Name)

| (1) Owner of Land: | Description & Color of Materials Sand, Clay, Red Clay, Shell, etc. | Thick- ness Feet | Depth Feet |
|---|---|------------------------|---------------|
| <u>Carl Wiesenberg</u> (Name) <u>Pascagoula, Miss.</u> (Address) | <u>Clay</u> | <u>20</u> | <u>20</u> |
| <u>Krebs Lake</u> (Address) | <u>surface sand</u> | <u>39</u> | <u>59</u> |
| (2) Location: <u>1/4</u> , <u>1/4</u> , Sec. <u>T8SR6W</u> miles <u>1W</u> , of <u>Pascagoula</u> (distance) (direction) (Nearest Town) | <u>Clay</u> → | <u>10</u> | <u>69</u> |
| (3) Topography: <u>level</u> (Hilly) (Flat) (Level) | <u>sand</u> | <u>51</u> | <u>120</u> |
| (4) Purpose of Well: <u>domestic</u> (Domestic Irrigation Municipal, Industrial, Other) | <u>Clay</u> | <u>131</u> | <u>251</u> |
| | <u>sand</u> | <u>49</u> | <u>300</u> |
| | <u>(top 12' of last strata fine sand, balance course)</u> | | |


Information upon completion of well:

- (1) Diameter 4 inches.
- (2) Total Depth 300 feet.
- (3) Water Level 43 feet below top of ground.
- (4) Cased to all, Size 4"
- (5) Screen: Size 4", Length 30'
- (6) Were any formations sealed against pollution?
_____ yes, no.

If YES depth of formation _____

Why _____

Drillers Remarks: _____

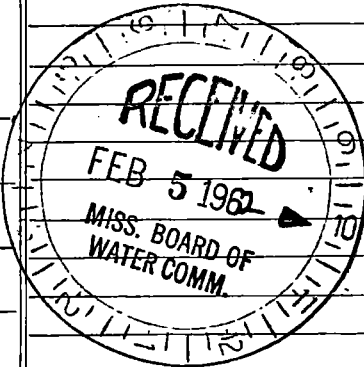

(Use Back Side)

Well No. _____

