

JACKSON MISSISSIPPI BOARD OF WATER COMMISSIONERS

P 189

2-15-62

WATER WELL DRILLERS LOG

Date: 2/15, 1962, Driller: Colville County JACKSON
 45 (Name)

(1) Owner of Land: Jake Hood
 (Name)
Gautier
 (Address)
IPR

(2) Location: SW 1/4, SW 1/4, Sec 7 R5R6W
 (distance) miles (direction) of (Nearest Town)

(3) Topography: (Hilly) (Flat) (Level)

(4) Purpose of Well: Domestic
 (Domestic Irrigation, Municipal, Industrial, Other)

Description & Color of Materials Sand, Clay, Red Clay, Shell, etc.		Thick- ness Feet	Depth Feet
<u>0</u>	<u>Slush</u>	<u>10</u>	<u>Clay</u>
<u>30</u>	<u>Sand</u>	<u>18</u>	<u>Clay</u>
<u>78</u>	<u>Sand</u>	<u>84</u>	<u>Clay</u>
<u>90</u>	<u>Sand</u>	<u>120</u>	<u>Clay</u>
<u>135</u>	<u>Sand</u>	<u>175</u>	<u>Clay</u>
<u>231</u>	<u>Sand</u>	<u>283</u>	
<u>J.P.</u>			

Information upon completion of well:

(1) Diameter 2 inches.


(2) Total Depth 283 feet.

(3) Water Level 2'-3" feet below top of ground.

(4) Cased to _____, Size _____

(5) Screen: Size 2, Length 10

(6) Were any formations sealed against pollution?
 _____ yes, _____ no.

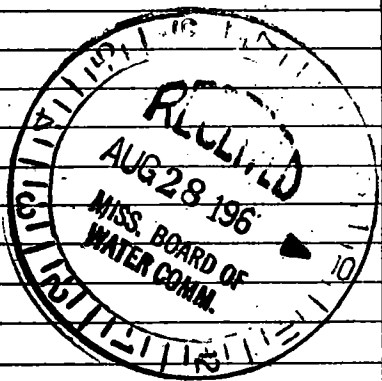

If YES depth of formation _____

Why _____

Drillers Remarks: _____

Well No. 108

(Use Back Side)

1910

...

...

