

JACKSON MISSISSIPPI BOARD OF WATER COMMISSIONERS

P 190

3-8-62

WATER WELL DRILLERS LOG

Date: 3/8, 1962, Driller: Colville County JACKSON
(Name)

(1) Owner of Land: <u>James Savage</u> <small>(Name)</small>	Description & Color of Materials Sand, Clay, Red Clay, Shell, etc.	Thick- ness Feet	Depth Feet
<u>Escatawpa</u> <small>(Address)</small>			
(2) Location: <u>SW 1/4, NW 1/4, Sec. 13 T25R6W</u>			
<u>1/2</u> miles <u>SW</u> of _____ <small>(distance) (direction) (Nearest Town)</small>			
(3) Topography: <u>✓</u> <small>(Hilly) (Flat) (Level)</small>			
(4) Purpose of Well: <u>Domestic</u> <small>(Domestic Irrigation Municipal, Industrial, Other)</small>			


Depth	Form	Depth	Form
0	CLAY	10	SAND
35	CLAY	42	SAND
105	CLAY	180	SAND
173	JD		

Information upon completion of well:

- (1) Diameter 1 1/4 inches.
- (2) Total Depth 173 feet.
- (3) Water Level 12 feet below top of ground.
- (4) Cased to _____, Size _____
- (5) Screen: Size 1 1/4, Length 10
- (6) Were any formations sealed against pollution?
 _____ yes, _____ no. ✓

If YES depth of formation _____
 Why _____

Drillers Remarks: _____

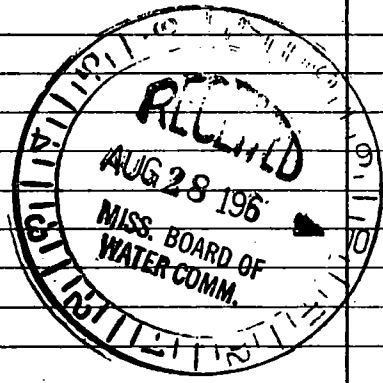

Well No. 1111

(Use Back Side)

Handwritten notes at the top of the page, including a date "8/18" and some illegible text.

Date	Description
8/18	...
8/19	...
8/20	...
8/21	...
8/22	...
8/23	...
8/24	...
8/25	...
8/26	...
8/27	...
8/28	...
8/29	...
8/30	...