

P 191

3-28-62

WATER WELL DRILLERS LOG

Date: 3/28, 1962, Driller: Colville County JACKSON  
49 (Name)

(1) Owner of Land: Joe Mc Cook  
(Name)  
Moss Point  
(Address)

(2) Location: SW 1/4, SE 1/4, Sec. 24 T5R L  
                         miles of                           
(distance) (direction) (Nearest Town)

(3) Topography:                          ✓  
(Hilly) (Flat) (Level)

(4) Purpose of Well: Industrial  
(Domestic Irrigation  
Municipal, Industrial, Other)

Description & Color of Materials Sand, Clay, Red Clay, Shell, etc.		Thick- ness Feet	Depth Feet
<i>Depth Form</i>	<i>Depth Form</i>		
0 Soft Clay	5	Soft clay	
21 Sand	30	Clay	
42 Sand	100	Clay	
105 Sand	194	JD	

Information upon completion of well:

(1) Diameter 1 1/4 inches.

(2) Total Depth 194 feet.

(3) Water Level 8 feet below top of ground.

(4) Cased to                          Size                         


(5) Screen: Size 1 1/4 Length 10

(6) Were any formations sealed against pollution?  
                         yes,                          no. ✓

If YES depth of formation                         

Why                         

Drillers Remarks:                         

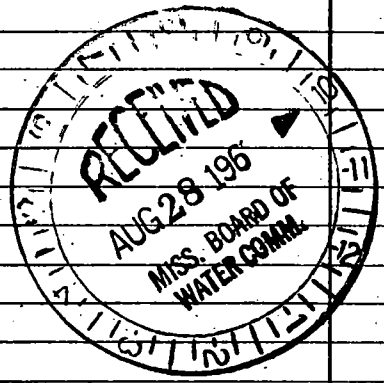

Well No. 115

(Use Back Side)

1. The first part of the document discusses the importance of maintaining accurate records of all transactions. It emphasizes that this is crucial for ensuring the integrity of the financial statements and for providing a clear audit trail.

2. The second part of the document outlines the various methods used to collect and analyze data. It includes a detailed description of the sampling process and the statistical techniques employed to draw conclusions from the data.

3. The third part of the document presents the results of the analysis. It shows that there is a significant correlation between the variables being studied, which supports the hypothesis that was tested.

4. The fourth part of the document discusses the implications of the findings. It suggests that the results have important implications for the field of study and that further research is needed to explore these findings in more detail.

5. The fifth part of the document concludes the study and provides a summary of the key findings. It also includes a list of references and a list of figures and tables.