

P193

4-24-62

WATER WELL DRILLERS LOG

Date: 4/24, 1962, Driller: Colville County: JACKSON

49

(Name)

(1) Owner of Land: Mrs Lottie Ross

(Name)

Escatawpa

(Address)

(2) Location: SE 1/4, NE 1/4, Sec. 9 T25R6W

miles of (distance) (direction) (Nearest Town)

(3) Topography: (Hilly) (Flat) (Level) [check Level]

(4) Purpose of Well: Domestic (Domestic Irrigation, Municipal, Industrial, Other)

Description & Color of Materials Sand, Clay, Red Clay, Shell, etc.

Thick-ness Feet


Depth Feet

Depth Form depth Form

0 clay 15 SAND
38 clay 46 SAND
90 clay 155 SAND
177 clay 341 SAND
356 ID

Information upon completion of well:

- (1) Diameter 1 1/4 inches.
(2) Total Depth 356 feet.
(3) Water level 8 feet below top of ground.
(4) Cased to, Size.
(5) Screen: Size 1 1/4, Length 10.
(6) Were any formations sealed against pollution? yes, no. [check no]

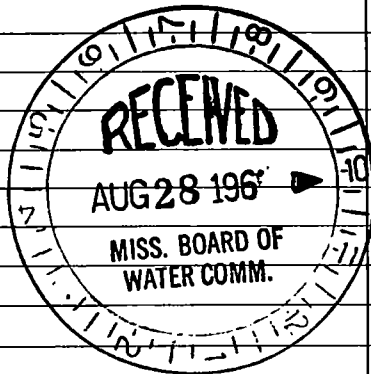

If YES depth of formation
Why
Drillers Remarks:

(Use Back Side)

Well No. 191

10/11/14

10/11/14

10/11/14

10/11/14