

P 196
6-14-62

WATER WELL DRILLERS LOG

Date: June 14, 1962, Driller: Andrew Colville County Jackson
49
(Name)

(1) Owner of Land: Horse Hutcherson
(Name)

Meautien Drive
(Address)

(2) Location: NW 1/4 SW 1/4, Sec. 3 T. 25 R. 6 W.

5 miles North, of Meautien
(distance) (direction) (Nearest Town)

(3) Topography: Hilly
(Hilly) (Flat) (Level)

(4) Purpose of Well: Domestic
(Domestic Irrigation
Municipal, Industrial, Other)

Description & Color of Materials
Sand, Clay, Red Clay, Shell, etc.

Thick-
ness
Feet

Depth
Feet

0-18 yellow clay
18-21 blue clay
21-42 streaks
42-63 clay
63-68 clay
68-84 sand
TD

Information upon completion of well:

(1) Diameter 1 1/4 inches.

(2) Total Depth 84 feet.

(3) Water Level 21' 11" feet below top of ground.

(4) Cased to _____, Size _____


(5) Screen: Size 1 1/4", Length 10'

(6) Were any formations sealed against pollution?
_____ yes, no.

If YES depth of formation _____

Why _____

Drillers Remarks: _____

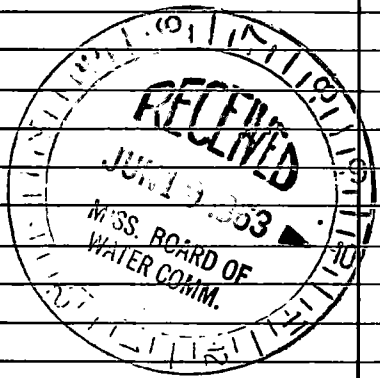

(Use Back Side)

Well No.
155

