

P 197

8-10-62

WATER WELL DRILLERS LOG

Date: Aug 10, 1962, Driller: Thin Colville County Jackson  
 & P (Name)


(1) Owner of Land: Sherry Richards  
 (Name)  
Executive Mrs  
 (Address)  
 (2) Location: NE 1/4, SE 1/4, Sec 2 T. 15 R. 6 W.  
4 miles North, of Moore Point  
 (distance) (direction) (Nearest Town)  
 (3) Topography: Flat  
 (Hilly) (Flat) (Level)  
 (4) Purpose of Well: Domestic  
 (Domestic Irrigation  
 Municipal, Industrial, Other)

Description & Color of Materials Sand, Clay, Red Clay, Shell, etc.	Thick- ness Feet	Depth Feet
0-21 Red clay		
21-42 Blue Clay		
42-52 clay		
52-63 sand		
63-78 sand		
TP		

Information upon completion of well:

(1) Diameter 1 1/4 inches.  
 (2) Total Depth 78 feet.  
 (3) Water Level 14 feet below top of ground.  
 (4) Cased to \_\_\_\_\_, Size \_\_\_\_\_  
 (5) Screen: Size 1 1/4, Length 50  
 (6) Were any formations sealed against pollution?  
 \_\_\_\_\_ yes, X no.

If YES depth of formation \_\_\_\_\_  
 Why \_\_\_\_\_  
 Drillers Remarks: \_\_\_\_\_

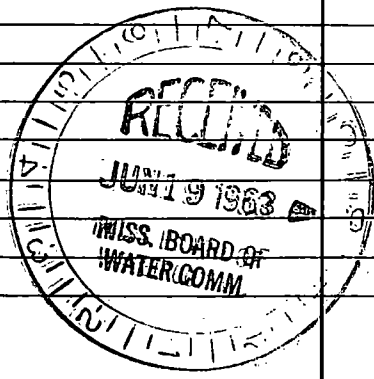

(Use Back Side)

Well No. 167

