

JACKSON MISSISSIPPI BOARD OF WATER COMMISSIONERS

P 198
9-4-62

WATER WELL DRILLERS LOG

Date: Sept 4, 1962, Driller: Alvin Colville County Jackson
5 @ (Name)


(1) Owner of Land: Thomas Roberts
(Name)
Gautier Miss
(Address)
(2) Location: Irregular Sect 31
1/4, Sec. T. 7 R. 6
5 W
miles _____ of _____
(distance) (direction) (Nearest Town)
(3) Topography: Flat
(Hilly) (Flat) (Level)
(4) Purpose of Well: Domestic
(Domestic Irrigation
Municipal, Industrial, Other)

Description & Color of Materials Sand, Clay, Red Clay, Shell, etc.	Thick- ness Feet	Depth Feet
0-2 Sand		
2-18 Clay		
18-50 sand		
50-63 sandy clay		
63-65 clay		
65-84 sand & gravel		
84-95 sand		
95-105 clay		
105-110 clay		
110-120 sand		
120-126 Gritty clay		
126-147 sand		
147-161 sand		
161-168 clay		
168-189 clay		
189-208 strainer		
208-210 clay		
210-231 strainer		
231-251 clean sand		
251-252 clay		
252-273 sand		
273-283 sand		
T.D		

Information upon completion of well:

(1) Diameter 1 1/4 inches.
(2) Total Depth 283 feet.
(3) Water Level 12' feet below top of ground.
(4) Cased to _____, Size _____
(5) Screen: Size 1 1/4, Length 10'
(6) Were any formations sealed against pollution?
_____ yes, X no.

If YES depth of formation _____
Why _____
Drillers Remarks: _____

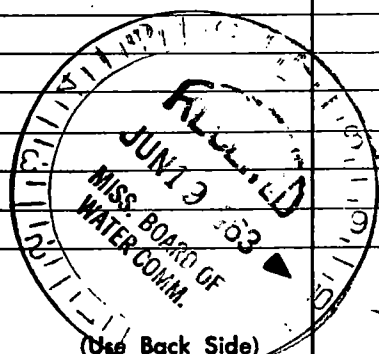

Well No. 191

