

JACKSON

P 200

WATER WELL DRILLERS LOG

11-11-62

Date: Nov. 11, 1962, Driller: M & B Drilling Co. County Jackson

49


- (1) Owner of Land: Mr. Blackwell
(Name) P.O. Box
Miss Point, Miss.
(Address)
- (2) Location: NW 1/4, 1/4, Sec. 1 T56N
2 miles N, of Escatawpa
(distance) (direction) (Nearest Town)
- (3) Topography: Flat
(Hilly) (Flat) (Level)
- (4) Purpose of Well: Domestic
(Domestic Irrigation
Municipal, Industrial, Other)

Description & Color of Materials Sand, Clay, Red Clay, Shell, etc.	Thick- ness Feet	Depth Feet
Black Clay	45	45
White Coarse Sand	50	95
Blue Clay	20	115
White Coarse Sand	35	150
Blue Clay	112	262
Sand Break	3	265
Blue Clay	70	335
Gray Sand	43	378

Information upon completion of well:

- (1) Diameter 2 inches.
- (2) Total Depth 374 feet.
- (3) Water Level 2 feet below top of ground.
- (4) Cased to 368, Size 2"
- (5) Screen: Sized 2" X 3/8", Length 6 FT.
- (6) Were any formations sealed against pollution?
no.

If YES depth of formation _____
 Why _____
 Drillers Remarks: _____

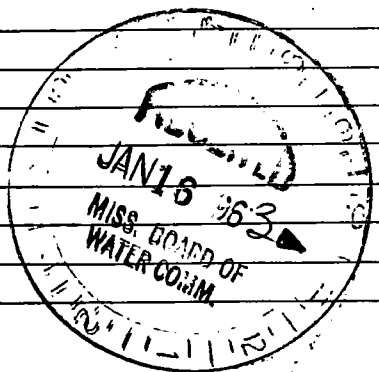

(Use Back Side)

Well No.

