

JACKSON MISSISSIPPI BOARD OF WATER COMMISSIONERS

P 202
3-19-63

WATER WELL DRILLERS LOG

Date: March 19, 1963, Driller: George Colville County Jackson
(Name)
 49

(1) Owner of Land: J. W. Walton
(Name)
Escatawpa Miss
(Address)

(2) Location: NW 1/4, NW 1/4, Sec. 17, T8 R6W
3 miles North, at Mose Road
(distance) (direction) (Nearest Town)

(3) Topography: Flat
(Hilly) (Flat) (Level)

(4) Purpose of Well: Domestic
(Domestic Irrigation
 Municipal, Industrial, Other)

| Description & Color of Materials Sand, Clay, Red Clay, Shell, etc. | Thick- ness Feet | Depth Feet |
|---|------------------------|---------------|
| Clay | | 8 |
| Sand | 14 | 22 |
| Clay | 132 | 154 |
| Gravel | 22 | 176 |
| Clay | 107 | 283 |
| Rock | 2 | 285 |
| Clay | 99 | 384 |
| Sand | 12 | 396 |

Information upon completion of well:

(1) Diameter 1 1/4 inches.

(2) Total Depth 396 feet.

(3) Water Level 2'-6" feet below top of ground.

(4) Cased to _____, Size _____.


(5) Screen: Size 1 1/4, Length 10'.

(6) Were any formations sealed against pollution?
 _____ yes, no.

If YES depth of formation _____.

Why _____.

Drillers Remarks: _____

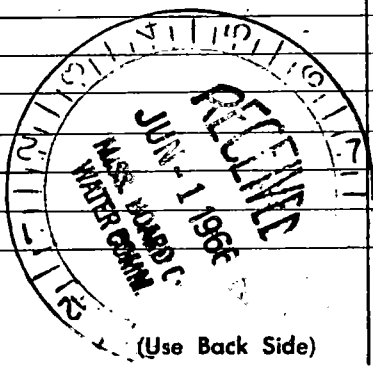

Well No. 204

