

Jackson  
P 205  
6-63

MISSISSIPPI  
BOARD OF WATER COMMISSIONERS  
416 North State Street  
Jackson, Mississippi 39201

WATER WELL DRILLERS LOG

June 15 1963 Control & Water Supply Co Inc Jackson  
date well completed firm name county well located


LANDOWNER: Ed Roger  
Escatawpa, Miss  
(mailing address)  
WELL LOCATION:  
sect 2 T 7 N R 6 E  
1/2 miles north of M.P.  
(distance) (direction) (nearest town)

description of formations encountered	from	to
Clay	0	42
Sand & gravel	42	70
Clay	70	100
Sand	100	105
Clay	105	150
Sand	150	172
Clay	172	315
Sand	315	330

WELL PURPOSE: house  
(home, irrigation, municipal, industrial)

WELL COMPLETION DATA:  
(1) diameter (inches) 1 1/4  
(2) total depth (feet) 330  
(3) static water level (feet) 9 below above top of ground.  
(4) casing \_\_\_\_\_ (material) \_\_\_\_\_ (depth) \_\_\_\_\_  
\_\_\_\_\_ (size) if telescope see back.  
(5) screen 5 \_\_\_\_\_ 325 \_\_\_\_\_  
(length) (depth to top)  
1 1/4 \_\_\_\_\_ brass \_\_\_\_\_  
(size) (material)  
(6) pump \_\_\_\_\_ (HP) \_\_\_\_\_ (yield gpm)  
\_\_\_\_\_ (type power)  
(7) electric log no \_\_\_\_\_  
(yes or no)  
\_\_\_\_\_ (organization running log)  
(8) how well bottom plugged BP Valve


DRILLERS REMARKS:

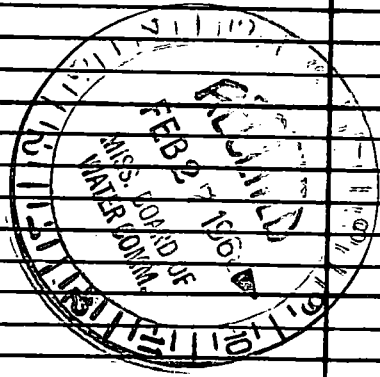

If well telescopes please sketch and show depths.

GROUND LEVEL

N W S W

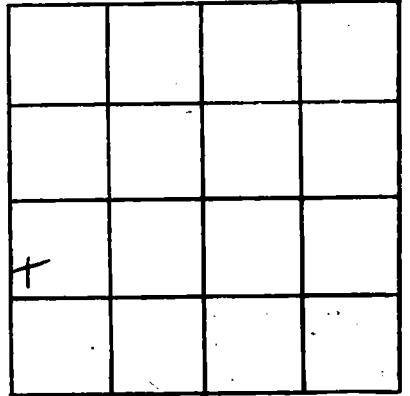

SECTION 12

Please indicate well location X.

ADDITIONAL INFORMATION

If more than one screen, show locations of each on sketch.