

49

Jackson
P206
7-63

MISSISSIPPI
 BOARD OF WATER COMMISSIONERS
 416 North State Street
 Jackson, Mississippi 39201

WATER WELL DRILLERS LOG

July 29 1963 date well completed
 LaBelle Water Supply firm name
 Jackson county well located

LANDOWNER: David Spivey

description of formations encountered	from	to
	Sand	0
clay	42	63
Sand	63	115
clay	115	180
Sand	180	187
clay	187	208
Sand	208	309
clay	309	362
Sand	362	414

Gautier Miss.
 (mailing address)

WELL LOCATION:

sec 8 T 8 N R 6 E
 4 miles west of Forest
 (distance) (direction) (nearest town)

WELL PURPOSE: none
(home, irrigation, municipal, industrial)

WELL COMPLETION DATA:

- (1) diameter (inches) 1 1/4
- (2) total depth (feet) ~~414~~ 414
- (3) static water level (feet) 9' ^{below} _{above} top of ground.
- (4) casing _____ (material) _____ (depth) _____
 _____ (size) if telescope see back.
- (5) screen 10' _____ 404' _____
 (length) (depth to top)
 1 1/4" _____
 (size) (material)
- (6) pump _____ (HP) _____ (yield gpm)
 _____ (type power)
- (7) electric log no
 (yes or no)
 _____ (organization running log)
- (8) how well bottom plugged BP Valve


DRILLERS REMARKS:



If well telescopes please sketch and show depths.

GROUND LEVEL

SE SW

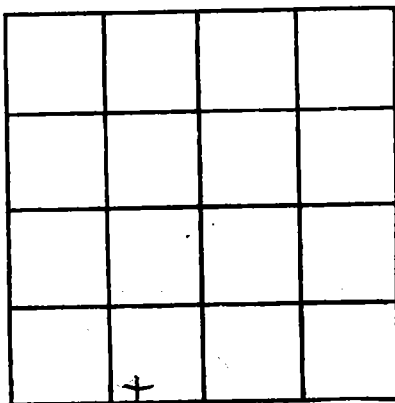

SECTION 8

Please indicate well location X.

ADDITIONAL INFORMATION

If more than one screen, show locations of each on sketch.