

P 207

7-63

WATER WELL DRILLERS LOG

Date: July 23, 1963, Driller: Colville Water ^{SUP} County Jackson
 49 (Name)

(1) Owner of Land: J.S. Hastings
 (Name)
Geatier, Miss.
 (Address)

(2) Location: NE 1/4, SW 1/4, Sec. 3 T3R6W
7 miles N, of Geatier
 (distance) (direction) (Nearest Town)

(3) Topography: FLAT
 (Hilly) (Flat) (Level)

(4) Purpose of Well: Dom
 (Domestic Irrigation
 Municipal, Industrial, Other)

Description & Color of Materials Sand, Clay, Red Clay, Shell, etc.	Thick- ness Feet	Depth Feet
CLAY	38	38
SAND	28	66
CLAY	22	88
SAND	6	94
CLAY	91	185
SAND	18	203
CLAY	90	293
SAND	15	308

Information upon completion of well:

(1) Diameter 1 1/4 inches.

(2) Total Depth 308 feet.

(3) Water Level 1'-0" ^{ABOVE} feet below top of ground.

(4) Cased to 303, Size 1 1/4


(5) Screen: Size .010, Length 5 ft.

(6) Were any formations sealed against pollution?
 _____ yes, no.

If YES depth of formation _____

Why _____

Drillers Remarks: _____

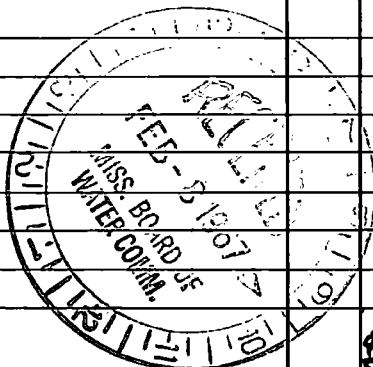

(Use Back Side)

Well No.
063

