

49  
 Jackson  
 P 208  
 8-63

MISSISSIPPI  
 BOARD OF WATER COMMISSIONERS  
 416 North State Street  
 Jackson, Mississippi 39201

WATER WELL DRILLERS LOG

Aug 14 1963 Colville Water Supply Jackson  
 date well completed firm name county well located

LANDOWNER: J.C. Cunningham

description of formations encountered

Mar Point Miss  
 (mailing address)

description of formations encountered	from	to
Clay	0	21
Sand	21	23

WELL LOCATION:

sec 15 T 7 N R 6 E  
 3 4  
 Mar Point  
 (distance) (direction) (nearest town)

WELL PURPOSE: Irrigation  
 (home, irrigation, municipal, industrial)

WELL COMPLETION DATA:

- (1) diameter (inches) ~~1 1/2~~ 2"
- (2) total depth (feet) 73
- (3) static water level (feet) 20' below top of ground.
- (4) casing \_\_\_\_\_ (material) \_\_\_\_\_ (depth) \_\_\_\_\_ (size) if telescope see back.
- (5) screen ~~0.5~~ 0.5 \_\_\_\_\_ 68 (length) (depth to top)  
 2 \_\_\_\_\_ Brown (size) (material)
- (6) pump \_\_\_\_\_ (HP) \_\_\_\_\_ (yield gpm)  
 \_\_\_\_\_ (type power)
- (7) electric log no (yes or no)  
 \_\_\_\_\_ (organization running log)
- (8) how well bottom plugged BP valve




DRILLERS REMARKS:

If well telescopes please sketch and show depths.

SESE

GROUND LEVEL

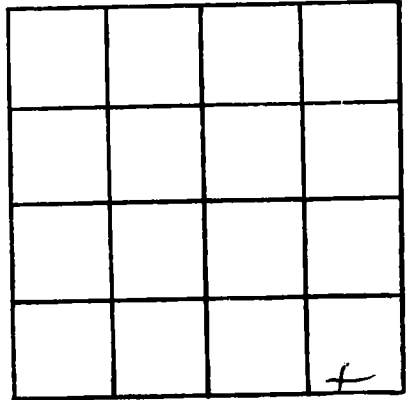

SECTION 15

Please indicate well location X.

ADDITIONAL INFORMATION

If more than one screen, show locations of each on sketch.