

49  
Jackson  
P209  
8-63

MISSISSIPPI  
 BOARD OF WATER COMMISSIONERS  
 416 North State Street  
 Jackson, Mississippi 39201

WATER WELL DRILLERS LOG

Aug 5 1963 Calville Water Supply Jackson  
 date well completed firm name county well located

LANDOWNER: C.C. Beeland


description of formations encountered	from	to
Clay	0	10
sand	10	21
clay	21	42
sand	42	54
Clay	84	126
sand	126	159
Clay	159	358
Sand	358	369

Coatumba Miss  
 (mailing address)

WELL LOCATION:  
 sec 9 T 7 N R 6 E  
 (S) (W)  
1/2 miles north of M.P.  
 (distance) (direction) (nearest town)

WELL PURPOSE: house  
 (home, irrigation, municipal, industrial)

- WELL COMPLETION DATA:
- diameter (inches) 1 1/4
  - total depth (feet) 369
  - static water level (feet) 2 <sup>below</sup> <sub>above</sub> top of ground.
  - casing \_\_\_\_\_ (material) \_\_\_\_\_ (depth) \_\_\_\_\_ (size) if telescope see back.
  - screen 10' 359  
 (length) (depth to top)  
1 1/4 brass  
 (size) (material)
  - pump \_\_\_\_\_ (HP) \_\_\_\_\_ (yield gpm)  
 \_\_\_\_\_ (type power)
  - electric log no  
 (yes or no)  
 \_\_\_\_\_ (organization running log)
  - how well bottom plugged B.P. Juby

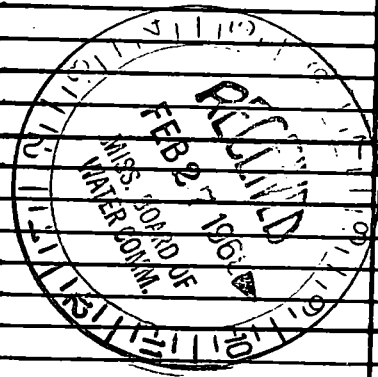

DRILLERS REMARKS:

If well telescopes please sketch and show depths.

GROUND LEVEL

NE NE

			+

SECTION 9

Please indicate well location X:

ADDITIONAL INFORMATION

If more than one screen, show locations of each on sketch.