

49

Jackson
P 210
8-63

MISSISSIPPI
 BOARD OF WATER COMMISSIONERS
 416 North State Street
 Jackson, Mississippi 39201

WATER WELL DRILLERS LOG

Aug 27 63 19 63 Atchafalaya Water Supply Jackson
 date well completed firm name county well located

LANDOWNER: Lois Amhurst

description of formations encountered	from	to

Escatawpa Miss
 (mailing address)

<u>Sand</u>	<u>0</u>	<u>63</u>
<u>Clay</u>	<u>63</u>	<u>84</u>
<u>Sand</u>	<u>84</u>	<u>94</u>

WELL LOCATION:


sec. 2 T. 7 N. R. 6 E.
2 1/2 miles NW of Escatawpa
 (distance) (direction) (nearest town)

WELL PURPOSE: home
 (home, irrigation, municipal, industrial)

WELL COMPLETION DATA:

- (1) diameter (inches) 1 1/4
- (2) total depth (feet) 94
- (3) static water level (feet) 2 1/2 below above top of ground.
- (4) casing _____ (material) _____ (depth) _____ (size) if telescope see back.
- (5) screen 1 1/4 _____ 89 _____ (length) (depth to top) _____ 1 1/4 _____ Brass _____ (size) (material)
- (6) pump _____ (HP) _____ (yield gpm) _____ (type power)
- (7) electric log no _____ (yes or no) _____ (organization running log)
- (8) how well bottom plugged B.P. Wells


DRILLERS REMARKS:

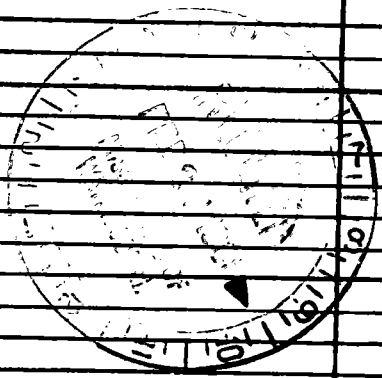

If well telescopes please sketch and show depths.

GROUND LEVEL

SE NW

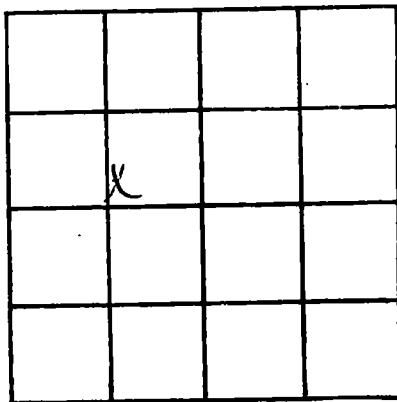

SECTION 2

Please indicate well location X.

ADDITIONAL INFORMATION

If more than one screen, show locations of each on sketch.