

59
 Jackson
 P 213
 10-63

MISSISSIPPI
 BOARD OF WATER COMMISSIONERS
 416 North State Street
 Jackson, Mississippi 39201

WATER WELL DRILLERS LOG

Oct 9 1965 date well completed
 World Water Supply firm name
 Jackson county well located

LANDOWNER: Paul Meyer

description of formations encountered	from to	
	feet	feet
Sand	0	42
Clay	42	55
Gravel	55	78

River Road, Pascagoula
 (mailing address)

WELL LOCATION:


? sec 30 T 7 N R 6 E
 36
 1 miles north of Pascagoula
 (distance) (direction) (nearest town)

WELL PURPOSE: irrigation
 (home, irrigation, municipal, industrial)

WELL COMPLETION DATA:

- (1) diameter (inches) 1 1/4
- (2) total depth (feet) 78
- (3) static water level (feet) 20 below above top of ground.
- (4) casing (material) (depth) (size) if telescope see back.
- (5) screen 5' 73 (length) (depth to top) 1 1/4 brass (size) (material)
- (6) pump (HP) (yield gpm) (type power)
- (7) electric log (yes or no) (organization running log)
- (8) how well bottom plugged B.P. Wiley


DRILLERS REMARKS:

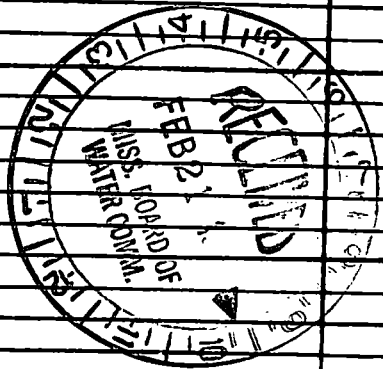

If well telescopes please sketch and show depths.

GROUND LEVEL

NWSE

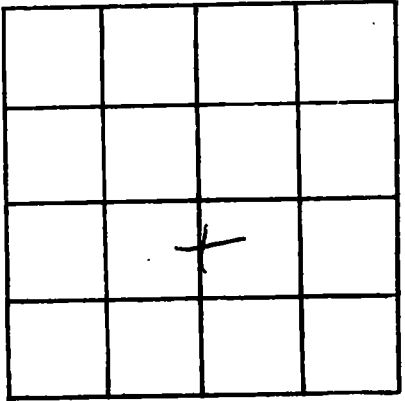

SECTION 30

Please indicate well location X.

ADDITIONAL INFORMATION

If more than one screen, show locations of each on sketch.