

Date: Oct 9, 1963, Driller: George Colville County Jackson
 + P (Name)


(1) Owner of Land: MARTIN BLAFF MISSIONS
 (Name)
Beutier, Miss
 (Address)
 (2) Location: NE 1/4, SE 1/4, Irreg 3 T3R6W
7 miles NORTH of Beutier
 (distance) (direction) (Nearest Town)
 (3) Topography: FLAT
 (Hilly) (Flat) (Level)
 (4) Purpose of Well: Dom
 (Domestic Irrigation
 Municipal, Industrial, Other)

Description & Color of Materials Sand, Clay, Red Clay, Shell, etc.	Thick- ness Feet	Depth Feet
CLAY	38	38
SAND	50	88
CLAY	88	176
SAND	66	242
CLAY	100	342
SAND	13	355
CLAY	173	528
SAND	32	560
CLAY	44	604
SAND	6	610
CLAY	32	642
SAND	28	670

Information upon completion of well:

(1) Diameter 2" 1/4 inches.
 (2) Total Depth 670 feet.
 (3) Water Level +3' Above feet below top of ground.
 (4) Cased to 660, Size 1 1/4
 (5) Screen: Size .008, Length 10'
 (6) Were any formations sealed against pollution?
 _____ yes, no.

If YES depth of formation _____
 Why _____
 Drillers Remarks: _____

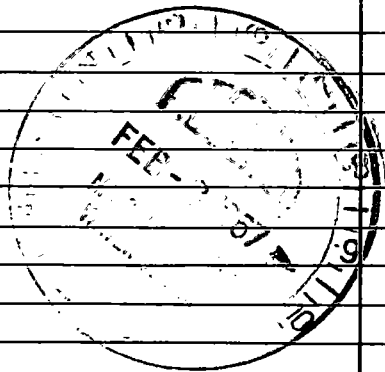

(Use Back Side)

Well No.
9217

