

Jackson
 P 215
 12-63
 48

MISSISSIPPI
 BOARD OF WATER COMMISSIONERS
 416 North State Street
 Jackson, Mississippi 39201

WATER WELL DRILLERS LOG

Dec 30 19 63 Calville Water Supply Jackson
 date well completed firm name county well located

LANDOWNER: Charley
Mary
Leontyne Miller
 (mailing address)

description of formations encountered	from to	
	feet	feet
Clay	0	63
Sand	63	74

WELL LOCATION:
 sec. 9 T. 7 N. R. 4 E. (E39)
4 miles south of Meridian
 (distance) (direction) (nearest town)

WELL PURPOSE: Domestic
 (home, irrigation, municipal, industrial)

WELL COMPLETION DATA:

- (1) diameter (inches) 1 1/4
- (2) total depth (feet) 78
- (3) static water level (feet) 11 ^{below} above top of ground.
- (4) casing (material) _____ (depth) _____
 (size) _____ if telescope see back.
- (5) screen 5' 73
 (length) (depth to top)
1 1/4 ~~_____~~
 (size) Plastic
- (6) pump _____ (HP) _____ (yield gpm)
 (type power) _____
- (7) electric log no
 (yes or no)
 (organization running log) _____
- (8) how well bottom plugged BP Value




DRILLERS REMARKS: _____

If well telescopes please sketch and show depths.

GROUND LEVEL

SWNE

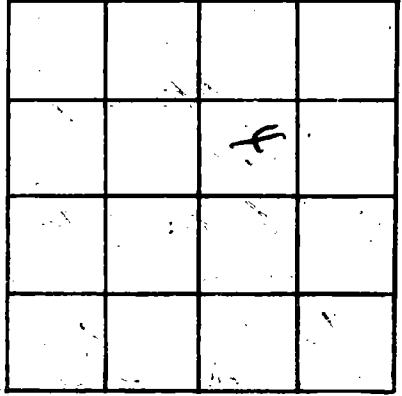

SECTION 9

Please indicate well location X.

ADDITIONAL INFORMATION

If more than one screen, show locations of each on sketch.