

49
 Jackson
 P217
 12-63

MISSISSIPPI
 BOARD OF WATER COMMISSIONERS
 416 North State Street
 Jackson, Mississippi 39201

WATER WELL DRILLERS LOG

Dec 14 1963 Calville Water Supply Jackson
 date well completed firm name county well located

LANDOWNER: Mr. RA
Sawnee
Goatawpa, Miss.
 (mailing address)

description of formations encountered	from to	
	feet	feet
Clay	0	21
Sand	21	89

WELL LOCATION:
 sec. 9 T. 7 N. R. 6 E (ESC)
4 miles north of Meridian
 (distance) (direction) (nearest town)

WELL PURPOSE: home
 (home, irrigation, municipal, industrial)

WELL COMPLETION DATA:

- (1) diameter (inches) 1 1/4
- (2) total depth (feet) 89
- (3) static water level (feet) 10 ^{below} _{above} top of ground.
- (4) casing Galv 57'
 (material) (depth)
1 1/4
 (size) if telescope see back.
- (5) screen 5 84
 (length) (depth to top)
1 1/4 brass
 (size) (material)
- (6) pump _____
 (HP) (yield gpm)
 (type power)
- (7) electric log no
 (yes or no)
 (organization running log)
- (8) how well bottom plugged BPU/valve


DRILLERS REMARKS:
Customer Inst.



If well telescopes please sketch and show depths.

GROUND LEVEL

SE NW

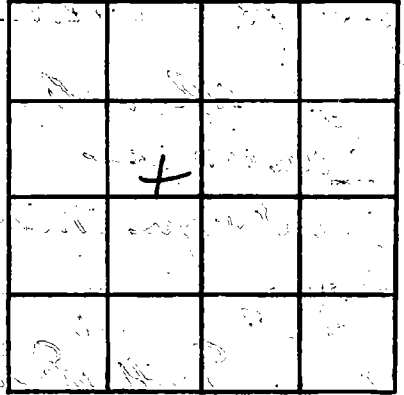

SECTION 9

Please indicate well location X:

ADDITIONAL INFORMATION

If more than one screen, show locations of each on sketch.