

# JACKSON MISSISSIPPI BOARD OF WATER COMMISSIONERS

P226  
1-3-66

## WATER WELL DRILLERS LOG

Date: 1-3-, 19 66, Driller: Carloss Well Supply County Jackson  
Shelby  
(Name)

(1) Owner of Land: Jackson County Bd. of Supervisors - Pascagoula (Jackson County), Mississippi

(2) Location: ESCATAWPA AREA - Well # 1  
NW 1/4, NW 1/4, Sec. 13 T2 R6

         miles          of           
(distance) (direction) (Nearest Town)

(3) Topography: Flat  
(Hilly) (Flat) (Level)

(4) Purpose of Well: Municipal  
(Domestic Irrigation  
Municipal, Industrial, Other)

### Information upon completion of well:

(1) Diameter 10 inches.

(2) Total Depth 345' feet.

(3) Water Level 16' feet below top of ground.

(4) Cased to 318', Size 10"

(5) Screen: Size 6", Length 22'-2"

(6) Were any formations sealed against pollution?


Yes yes,          no.

If YES depth of formation         

Casing cemented entire length.  
Why         

Drillers Remarks:         

Description & Color of Materials Sand, Clay, Red Clay, Shell, etc.	Thick- ness Feet	Depth Feet
Clay	7	7'
Roots, Logs, Silt	23	30'
Sand	30	60'
Sand and Clay Streaks	20	80'
Sand and Fine Gravel	40	120'
Blue Sandy Clay	9	129'
Gravel	14	143'
Blue Mud and Sandy Clay	10	153'
Hard Blue Shale & Small Gravel	22	175'
Sand Streaks, Blue Shale and Mud	142	317'
Med. Fine W.B. Sand	28	345'
Clay	17	362'

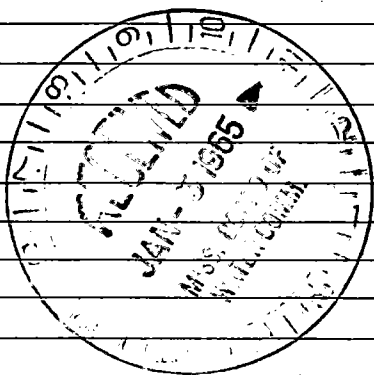

(Use Back Side)

Well No.

