

JACKSON

MISSISSIPPI BOARD OF WATER COMMISSIONERS

P. 227

12-31-65 WATER WELL DRILLERS LOG

Date: Dec. 31, 1965, Driller: Carlross Well Supply County Jackson Shelby

(Name)

(1) Owner of Land: Jackson Co. Bd. of Supervisors --(Name) Pascagoula, (Jackson Co.) Mississippi (Address)

(2) Location: 1/4, 1/4, Sec. T R ESCATAWPA AREA - Well # 2 miles of (distance) (direction) (Nearest Town)

(3) Topography: Flat (Hilly) (Flat) (Level)

(4) Purpose of Well: Municipal (Domestic Irrigation Municipal, Industrial, Other)

Table with 3 columns: Description & Color of Materials, Thickness Feet, Depth Feet. Rows include Clay, Silty Sand, Sand, Sand with Clay Streaks, Coarse Sand & Fine Gravel, Blue Sandy Clay, Gravel, Soft Blue Mud and Sand, Hard Blue Shale -- Strks of Gravel, Sticky Blue Clay, Soft Shale and Fine Sand, Hard Tough Blue Clay, Break Fine Med White Sand Blue Shale, Medium Water Bearing Sand, Tough Blue Clay.


Information upon completion of well:

- (1) Diameter 10" inches.
(2) Total Depth 347' feet.
(3) Water Level 14'-5" feet below top of ground.
(4) Cased to 321', Size 10"
(5) Screen: Size 6", Length 22'
(6) Were any formations sealed against pollution? X yes, no.

If YES depth of formation Casing cemented entire length

Why

Drillers Remarks:

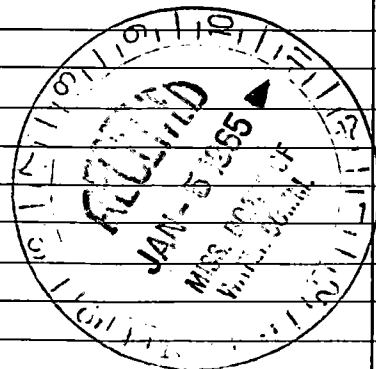

(Use Back Side)

Well No.

