

50

Jackson P 230

4-64

MISSISSIPPI
 BOARD OF WATER COMMISSIONERS
 416 North State Street
 Jackson, Mississippi 39201

WATER WELL DRILLERS LOG

April 3 1944 Chickie Water Supply Jackson
 date well completed firm name county well located

LANDOWNER: Lake Drive-In Theater

Pascagoula Miss
 (mailing address)

WELL LOCATION:
 sec 7 T 8 N R 1 E
5 Pascagoula W
 miles (distance) of (direction) (nearest town)

WELL PURPOSE: irrigation
 (home, irrigation, municipal, industrial)

WELL COMPLETION DATA:


- (1) diameter (inches) 2"
 (2) total depth (feet) 70.5
 (3) static water level (feet) 14' 3/4 below top of ground.
 (4) casing galv. (material) (depth) _____
 _____ if telescope see back.
 (size) _____
 (5) screen 5 (length) 100 (depth to top)
2" (size) plastic (material)

- (6) pump _____ (HP) _____ (yield gpm)
 _____ (type power)
 (7) electric log no (yes or no)

_____ (organization running log)
 (8) how well bottom plugged BP Valve

DRILLERS REMARKS:

description of formations encountered	from	to
Shush	0	21
clay	21	50
shells	50	55
clay	55	73
sand	73	105

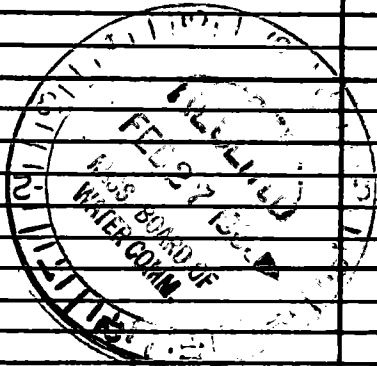

If well telescopes please sketch and show depths.

GROUND LEVEL

SWNE

SECTION 57

Please indicate well location X.

ADDITIONAL INFORMATION

If more than one screen, show locations of each on sketch.