

Jackson
 P 231
 5-64
 49

MISSISSIPPI
 BOARD OF WATER COMMISSIONERS
 416 North State Street
 Jackson, Mississippi 39201

WATER WELL DRILLERS LOG

May 27 19 44 Central Water Supply Jackson
 date well completed firm name county well located

LANDOWNER: W. R. Gunt
 Jr. 961 Riverwood Drive
Osageola, Miss
 (mailing address)

| description of formations encountered | from to | |
|---------------------------------------|-----------|-----------|
| | feet | feet |
| <u>yellow and blue clay</u> | <u>0</u> | <u>55</u> |
| <u>sand and gravel</u> | <u>55</u> | <u>89</u> |

WELL LOCATION:
 sec. 35 T 7 N R 6 E
mid-way MP. and Osageola
 (distance) (direction) (nearest town)


WELL PURPOSE: irrigation
 (home, irrigation, municipal, industrial)

WELL COMPLETION DATA:

- (1) diameter (inches) 2
- (2) total depth (feet) 89'
- (3) static water level (feet) 18 ^{below} _{above} top of ground.
- (4) casing galv
 (material) (depth)
 _____ if telescope see back.
 (size)
- (5) screen 10 77
 (length) (depth to top)
2" brass slot
 (size) (material)
- (6) pump _____
 (HP) (yield gpm)

 (type power)
- (7) electric log no
 (yes or no)

 (organization running log)
- (8) how well bottom plugged B.P. valve

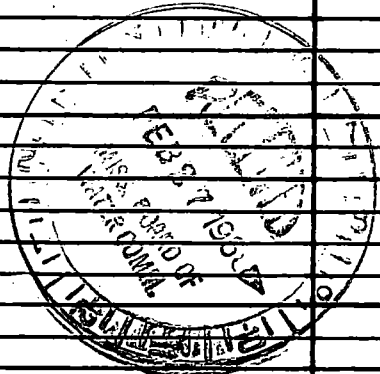

DRILLERS REMARKS:

If well telescopes please sketch and show depths.

N W N W

GROUND LEVEL

| | | | |
|---|--|--|--|
| X | | | |
| | | | |
| | | | |
| | | | |

SECTION 35

Please indicate well location X.

ADDITIONAL INFORMATION

If more than one screen, show locations of each on sketch.