

MISSISSIPPI BOARD OF WATER COMMISSIONERS

JACKSON
P 233
8-28-64

26/

WATER WELL DRILLERS LOG

Date: Aug 28, 1964, Driller: M & B Drilling Co. County Jackson

(Name)

(1) Owner of Land: Mr. Smith
(Name)
Pautee, Miss.
(Address)

(2) Location: 1/4, 1/4, Sec 31 D&K Co
Pautee miles, of Pautee
(distance) (direction) (Nearest Town)

(3) Topography: Flat
(Hilly) (Flat) (Level)

(4) Purpose of Well: Domestic
(Domestic Irrigation
Municipal, Industrial, Other)

Description & Color of Materials Sand, Clay, Red Clay, Shell, etc.	Thick- ness Feet	Depth Feet
Clay	20	20
Clay & Sand	25	45
Coarse White Sand	13	58
Grey Clay	4	62
Blue Clay	4	66
Grey Clay	50	116
Grey Clay & Sand Brecks	99	215
Grey Sand	6	221
Blue Clay	7	230
Coarse Grey Sand	52	282

Information upon completion of well:

(1) Diameter 2 inches.

(2) Total Depth 282 feet.

(3) Water Level 17 feet below top of ground.

(4) Cased to 272, Size 2"

(5) Screen: Size 2" X 8 ft, Length 10 ft.


(6) Were any formations sealed against pollution?
_____ yes, _____ no.

If YES depth of formation _____

Why _____

Drillers Remarks: _____

Still cutting sand when stopped Drilling

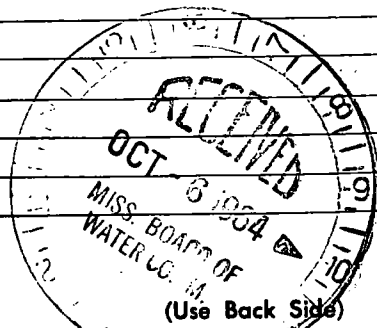

Well No.

