

# JACKSON MISSISSIPPI BOARD OF WATER COMMISSIONERS

P 234

12-24-64

## WATER WELL DRILLERS LOG

Date: 12-24, 1964, Driller: Sutter Well Works County Jackson  
(Name)

(1) Owner of Land: Gautier School  
(Name)  
Gautier Miss.  
(Address)

(2) Location: NE 1/4, NW 1/4, Sec. 9 T8S R6W  
       miles IN of Gautier  
(distance) (direction) (Nearest Town)

(3) Topography: flat  
(Hilly) (Flat) (Level)

(4) Purpose of Well: School  
(Domestic Irrigation Municipal, Industrial, Other)

Description & Color of Materials Sand, Clay, Red Clay, Shell, etc.	Thick- ness Feet	Depth Feet
Clay	25	25
sand	73	98
clay	14	112
sand	53	165
clay	47	212
sand	94	306
Clay	76	382
sand	27	419
Clay & sand streaks	242	661
sand	49	710
Clay	3	713

Information upon completion of well:

(1) Diameter 3 1/4 inches.

(2) Total Depth 713 feet.

(3) Water Level 5 feet below top of ground.

(4) Cased to all, Size Top 105' 4" 3", Size Below 3".


(5) Screen: Size 3", Length 40'.

(6) Were any formations sealed against pollution?  
 yes,  no.

If YES depth of formation 25'

Why Requested

Drillers Remarks: 3' blank pipe below screen

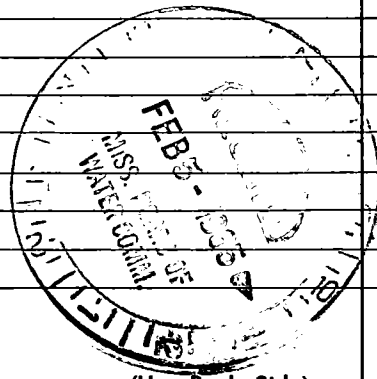

(Use Back Side)

Well No.

Faint, illegible text at the top of the page, possibly a header or title.

Vertical text on the left side, possibly a list or index.

Vertical text in the middle-left section, possibly a list or index.

Main body of faint, illegible text in the middle-right section.

Large area of extremely faint, illegible text at the bottom of the page.