

Jackson
P235

MISSISSIPPI BOARD OF WATER COMMISSIONERS

3-10-66

WATER WELL DRILLERS LOG

Date: Mar 10, 1966, Driller: T.C. STARK (Colville) County Jackson

49

(Name)

(1) Owner of Land: Cecil P. McFee
(Name)
Gautier, Miss.
(Address)

(2) Location: NW 1/4, NW 1/4, Sec 3 T28R6W
7 miles NW of Posey
(distance) (direction) (Nearest Town)

(3) Topography: Level
(Hilly) (Flat) (Level)

(4) Purpose of Well: DOM
(Domestic Irrigation
Municipal, Industrial, Other)

Description & Color of Materials Sand, Clay, Red Clay, Shell, etc.	Thick- ness Feet	Depth Feet
CLAY	20	20
SAND	60	80
CLAY	74	154
SAND	56	210
CLAY	10	220
SAND + CLAY STRKS	22	242
SAND	30	272
CLAY	52	324
SAND	26	350
CLAY	236	586
CLAY w/ SAND STRKS	2	594
FINE SAND	22	616
SAND	28	644


Information upon completion of well:

- (1) Diameter 2 inches.
- (2) Total Depth 644 feet.
- (3) Water Level 76 feet above below top of ground.
- (4) Cased to 639, Size 2 in.
- (5) Screen: Size 2 in. 1008, Length 5 ft.
- (6) Were any formations sealed against pollution?
no.

If YES depth of formation _____

Why _____

Drillers Remarks: _____

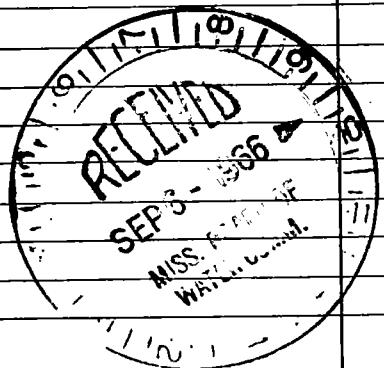

(Use Back Side)

Well No.

