

Jackson
P 237
4-20-66

MISSISSIPPI BOARD OF WATER COMMISSIONERS

WATER WELL DRILLERS LOG

Date: APR 20, 1966, Driller: TC. STORK (Edville) County: Jackson
4 P (Name)

(1) Owner of Land: Town Market
(Name)
Inalls Ave AT Market St.
(Address)

Description & Color of Materials Sand, Clay, Red Clay, Shell, etc.	Thick- ness Feet	Depth Feet
<u>0 Lgy</u>	<u>66</u>	<u>66</u>
<u>sand</u>	<u>18</u>	<u>84</u>

(2) Location: SE 1/4, SE 1/4, Sec. 5 T8R6W
Passo
miles _____ of _____
(distance) (direction) (Nearest Town)

(3) Topography: Level
(Hilly) (Flat) (Level)

(4) Purpose of Well: AIR CONDITIONER
(Domestic Irrigation
Municipal, Industrial, Other)


Information upon completion of well:

- (1) Diameter 1 1/4 inches.
- (2) Total Depth 84 feet.
- (3) Water Level 16 feet below top of ground.
- (4) Cased to 79, Size 1 1/4.
- (5) Screen: Size 1 1/4 80 mesh, Length 5 ft.
- (6) Were any formations sealed against pollution?
 yes, no.

If YES depth of formation _____

Why _____

Drillers Remarks: _____

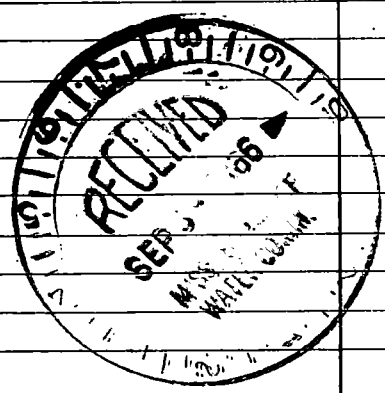

Well No.

(Use Back Side)

