

Jackson MISSISSIPPI BOARD OF WATER COMMISSIONERS

P 241

6-66

WATER WELL DRILLERS LOG

Date: June 4, 1966, Driller: T. C. STORK (Colville) County Jackson

(Name)

(1) Owner of Land: FRANCES G. LARSON

(Name)

BOUTIER MISS

(Address)

(2) Location: SE 1/4, SE 1/4, Sec. 2 T83R6W

1 REG

3 miles W of Boscobel

(distance)

(direction)

(Nearest Town)

(3) Topography: Level

(Hilly)

(Flat)

(Level)

(4) Purpose of Well: MOTEL

(Domestic Irrigation
Municipal, Industrial, Other)

Description & Color of Materials
Sand, Clay, Red Clay, Shell, etc.

Thick-
ness
Feet

Depth
Feet

CLAY	22	22
SAND, SHELLS & WOOD	22	44
SAND	22	66
GRAVEL	22	88
WOOD & SAND	22	110
SAND	83	193
CLAY	5	198
SAND	110	308
CLAY	92	380
SAND	35	415
CLAY	47	462
SAND	5	467
CLAY	45	512
SAND	38	550
CLAY	100	660
SAND	44	704
GRITTY CLAY	76	780
SAND	70	850

Information upon completion of well:

(1) Diameter 2 inches.

(2) Total Depth 850 feet.

(3) Water Level 5 feet Above top of ground.

(4) Cased to 840, Size 2 in.

(5) Screen: Size .010, Length 10 ft.


(6) Were any formations sealed against pollution?

yes, no.

If YES depth of formation _____

Why _____

Drillers Remarks: _____

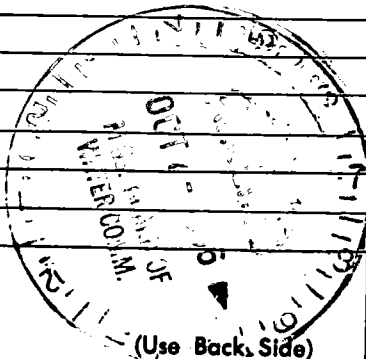

(Use Back Side)

Well No. _____

