

D242

8-66

WATER WELL DRILLERS LOG

Date: Aug 24, 19 66, Driller: TO STARK (Colville) County Jackson
 X P (Name)

(1) Owner of Land: G.F. Bostwick
(Name)
Gautier, Miss.
(Address)

(2) Location: SE 1/4, SE 1/4, Sec. 8 T2S R6W
3 miles W of POSCOBOLA
(distance) (direction) (Nearest Town)

(3) Topography: FLAT
(Hilly) (Flat) (Level)

(4) Purpose of Well: DOM
(Domestic Irrigation
 Municipal, Industrial, Other)


Description & Color of Materials Sand, Clay, Red Clay, Shell, etc.	Thick- ness Feet	Depth Feet
SAND	6	6
CLAY	18	24
SAND	6	30
CLAY	30	60
SAND	62	122
CLAY	78	200
SAND	15	215
CLAY	3	218
CLAY & SAND STRKS	24	242
SAND	27	269

Information upon completion of well:

- (1) Diameter 3 inches.
- (2) Total Depth 269 feet.
- (3) Water Level 21 feet below top of ground.
- (4) Cased to 249, Size 3 in.
- (5) Screen: Size 010, Length 10 ft.
- (6) Were any formations sealed against pollution?
 yes, no.

If YES depth of formation _____
 Why _____

Drillers Remarks: _____

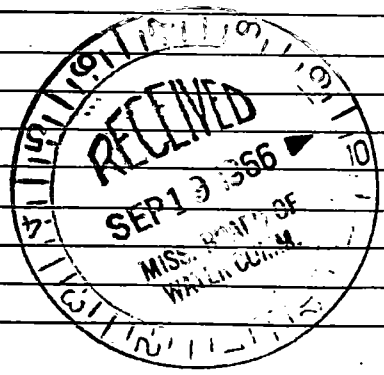

(Use Back Side)

Well No.

