

49

Jackson

P243

3-67

MISSISSIPPI
BOARD OF WATER COMMISSIONERS
416 North State Street
Jackson, Mississippi 39201

WATER WELL DRILLERS LOG

3-13 1967 Coast Water Well Drilling Co.
date well completed firm name county well located

LANDOWNER: Huck Smith

description of formations encountered

from to

Auster, Miss.

Red Clay	0	10
Zone sands	10	21
Blue clay	21	42
Sand med-coarse	42	105
Clay (Blue) & sand shale	105	126
Sand med-coarse	126	168
Blue Clay & shale	168	210
Sand med-coarse	210	294
Blue Clay & shale	294	379
Sand fine-coarse	379	409

(mailing address)

WELL LOCATION:

sec. 8 T. 7 N. R. 6 E.
S. W.
3 miles West of Princeton
(distance) (direction) (nearest town)

WELL PURPOSE: Home
(home, irrigation, municipal, industrial)


WELL COMPLETION DATA:

- (1) diameter (inches) 2
- (2) total depth (feet) 409
- (3) static water level (feet) 8 below top of ground.
- (4) casing 2" galv 405'
(material) (depth)
- 2"
(size) if telescope see back.
- (5) screen 5' 405'
(length) (depth to top)
- 2" Stainless
(size) (material)
- (6) pump 1/2 750
(HP) (yield gpm)
- Elect.
(type power)
- (7) electric log NO
(yes or no)
- (organization running log)

(8) how well bottom plugged Tapered
Run (Prop)

DRILLERS REMARKS: The map that I have in Bee Magazine U.S. Geological Survey, 1960 does not give sec. here

This map came with Bulletin 63-1, if you have a later one please send me one

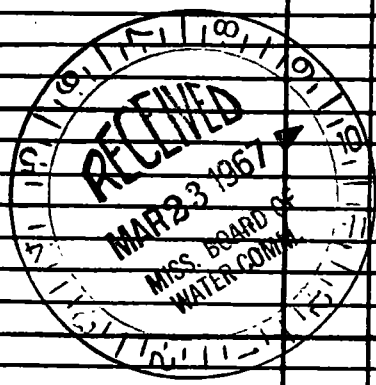

If well telescopes please sketch and show depths.

GROUND LEVEL

Jackson County
GRID P 2

##		X	

SWSE

SECTION

78

Please indicate well location X.

ADDITIONAL INFORMATION

This well is within
10 ft. from well NO 89
Grid Jackson county
on Base map By U.S.
Geological Survey, 1960
that same with
Citation 63-1 Jan. 1963
If there is any question
please write me
Frank
H.O. Rydell

If more than one screen,
show locations of each on sketch: