

49

| |
|---------|
| Jackson |
| P 244 |
| 4-67 |

MISSISSIPPI
 BOARD OF WATER COMMISSIONERS
 416 North State Street
 Jackson, Mississippi 39201

WATER WELL DRILLERS LOG

4-15-1967 date well completed Coastwater Well Dr Jackson firm name County well located

LANDOWNER: George Martin
 Gautier, Miss.

| description of formations encountered | from | to |
|---------------------------------------|------|----|
| Red Clay | 0 | 12 |
| blue sand | 12 | 30 |
| blue clay | 30 | 42 |
| hard red clay | 42 | 67 |

(mailing address)

WELL LOCATION:

sec. 31 T 7 N R 6 E
 S
 0 miles at of Gautier
 (distance) (direction) (nearest town)


WELL PURPOSE: Boat Sales
 (home, irrigation, municipal, industrial)

WELL COMPLETION DATA:

- (1) diameter (inches) 1 1/4"
- (2) total depth (feet) 63
- (3) static water level (feet) 12 below top of ground.
- (4) casing 1 1/4" 58' (material) (depth)
 1 1/4" If telescope see back. (size)
- (5) screen 5' 58' (length) (depth to top)
 1 1/4" Brass (size) (material)
- (6) pump 1/2 600 (HP) (yield gpm)
 Elect (type power)
- (7) electric log NO (yes or no)
 (organization running log)

(8) how well bottom plugged
 Back Wash Valve

DRILLERS REMARKS:

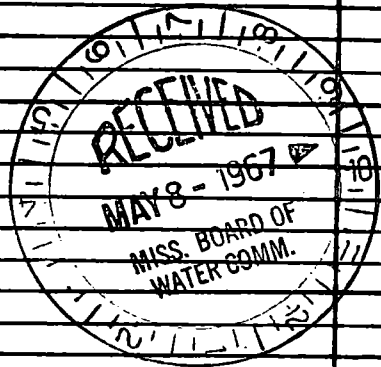

If well telescopes please sketch and show depths.

GROUND LEVEL

NE SW

| | | | |
|--|---|--|--|
| | | | |
| | | | |
| | X | | |
| | | | |

SECTION 31

Please indicate well location X.

ADDITIONAL INFORMATION

If more than one screen, show locations of each on sketch.