

59

Jackson  
P 245  
8-67

MISSISSIPPI  
BOARD OF WATER COMMISSIONERS  
416 North State Street  
Jackson, Mississippi 39201

WATER WELL DRILLERS LOG

Aug. 25 1967 Coast Water Well Service Jackson  
date well completed firm name county well located

LANDOWNER: A. Dantzler

Beach Blvd  
Passapatanz, Miss.  
(mailing address)

description of formations encountered	from	to
Fine White sand	0	10
Blue Mud	10	25
Blue mud <del>with</del> shell	25	42
Medium sand	42	65
Coarse Sand	65	94


WELL LOCATION:

sec. 8 T N R 6 E  
S W  
1/4 miles City of Passapatanz  
(distance) (direction) (nearest town)

WELL PURPOSE: Irrigation  
(home, irrigation, municipal, industrial)

WELL COMPLETION DATA:

- (1) diameter (inches) 2 in.
- (2) total depth (feet) 94 ft.
- (3) static water level (feet) 10 below top of ground. ~~below~~
- (4) casing Galv. 84 ft.  
(material) (depth)  
2 in. if telescope see back.  
(size)
- (5) screen 10 ft. 84 ft.  
(length) (depth to top)  
10 slot Stainless steel  
(size) (material)
- (6) pump one 3.5  
(HP) (yield gpm)  
Elect.  
(type power)
- (7) electric log no  
(yes or no)  
N. A.  
(organization running log)
- (8) how well bottom plugged  
Backwash valve

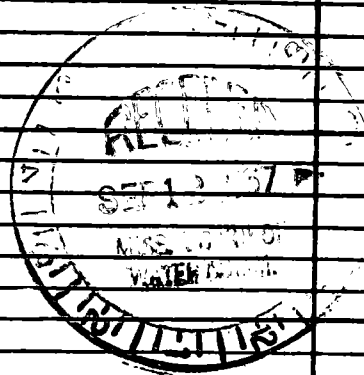

DRILLERS REMARKS:

If well telescopes please sketch and show depths.

GROUND LEVEL



SECTION \_\_\_\_\_

Please indicate well location X.

ADDITIONAL INFORMATION


If more than one screen, show locations of each on sketch.