

JACKSON
 P 247
 9-67
 4 5

MISSISSIPPI
 BOARD OF WATER COMMISSIONERS
 416 North State Street
 Jackson, Mississippi 39201

WATER WELL DRILLERS LOG


9/2/67 19 COAST WATER WELL SERVICE JACKSON
 date/well completed firm name county well located

LANDOWNER: RICHARD JACKSON
 GAUTIER MISS.
 (mailing address)
 WELL LOCATION:
 sec. 9 T. 8 N. R. 6 E. S. 1 W.
 miles of GAUTIER
 (distance) (direction) (nearest town)

description of formations encountered	from	to
BLUE CLAY	0	17
MED. - COARSE SAND - GRAVEL	17	55
Blue Clay	55	66
MED. SAND	66	89

WELL PURPOSE:
 (home, irrigation, municipal, industrial)

WELL COMPLETION DATA:
 (1) diameter (inches) 1 1/4"
 (2) total depth (feet) 89'
 (3) static water level (feet) 6 below top of ground.
 (4) casing GALV. IRON 84' (material) (depth)
 1 1/4" (size) if telescope see back.
 (5) screen 5' 84' (length) (depth to top)
 1 1/4" PLASTIC (size) (material)
 (6) pump 1/2 12 (HP) (yield gpm)
 Elect (type power)
 (7) electric log NO (yes or no)
 (organization running log)
 (8) how well bottom plugged BACKWASH VALVE

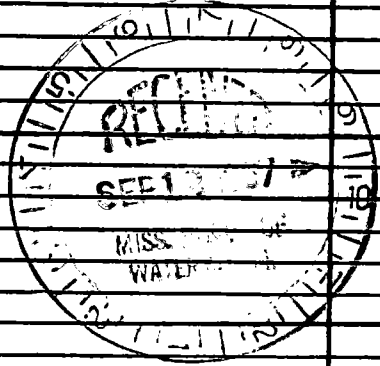

DRILLERS REMARKS: Hit Blue CLAY AGAIN about 90'

If well telescopes please sketch and show depths.

GROUND LEVEL

NW NW

X			

SECTION 9

Please indicate well location X.

ADDITIONAL INFORMATION

If more than one screen, show locations of each on sketch.