

**MISSISSIPPI  
BOARD OF WATER COMMISSIONERS**  
416 North State Street  
Jackson, Mississippi 39201

**WATER WELL DRILLERS LOG**

Jackson  
D248  
9-67  
49

9-26 1967 date well completed      Switzer Well Co. firm name      JACKSON county well located


LANDOWNER: <u>Hully Seafood Co.</u>	description of formations encountered	from	to
<u>Hwy 67 on Escatawpa River</u>			
(mailing address)	<u>sand, logs + muck</u>	<u>0</u>	<u>22</u>
	<u>sand</u>	<u>22</u>	<u>118</u>
	<u>clay</u>	<u>118</u>	<u>151</u>
	<u>sand</u>	<u>151</u>	<u>200</u>

**WELL LOCATION:**  
sec 24 T 7 S R. 6 E W  
1/2 miles S of ESCATAWPA  
(distance) (direction) (nearest town)

**WELL PURPOSE:** INDUSTRIAL  
(home, irrigation, municipal, industrial)

- WELL COMPLETION DATA:**
- (1) diameter (inches) 4
  - (2) total depth (feet) 200
  - (3) static water level (feet) 13 below top of ground.
  - (4) casing gal steel, 180'  
(material) (depth)  
4" If telescope see back.  
(size)
  - (5) screen 20', 180'  
(length) (depth to top)  
8 ga, SS on pipe  
(size) (material)
  - (6) pump 1, 15  
(HP) (yield gpm)
  - ELECTRIC  
(type power)
  - (7) electric log no  
(yes or no)  
  
(organization running log)
  - (8) how well bottom plugged Back  
pressure valve


**DRILLERS REMARKS:**

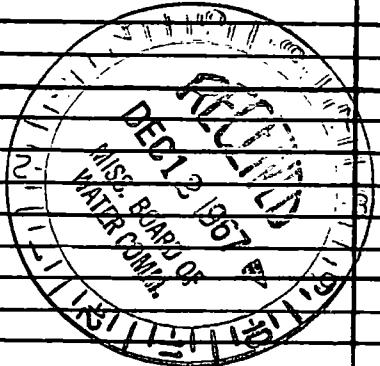

If well telescopes please sketch and show depths.

GROUND LEVEL

SW NE

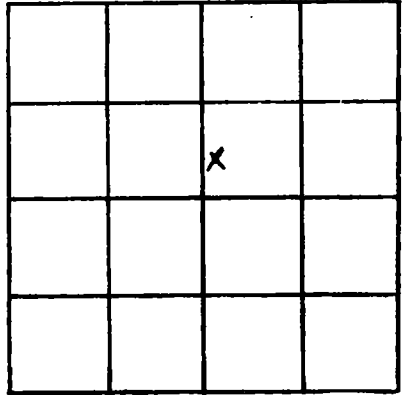

SECTION 24

Please indicate well location X.

ADDITIONAL INFORMATION

If more than one screen, show locations of each on sketch.