

~~9/27~~

P 249

WATER WELL DRILLERS LOG

Colville

Date: 9/27, 1960, Driller: Water Supply Co. County: JACKSON
 419 (Name)

(1) Owner of Land: GR Hardy
 (Name)
Escatawpa Miss
 (Address)
 (2) Location: NE 1/4, SW 1/4, Sec 13 T7S R6W
 _____ miles _____ of _____
 (distance) (direction) (Nearest Town)
 (3) Topography: _____
 (Hilly) (Flat) (Level)
 (4) Purpose of Well: _____
 Domestic Irrigation
 Municipal, Industrial, Other

Description & Color of Materials Sand, Clay, Red Clay, Shell, etc.		Thick- ness Feet	Depth Feet
0	Sandy clay	21	Clay
30	Clay	42	SAND
112	Clay	160	SAND
189			

Depth Form Depth Form

Total Depth


189'

Information upon completion of well:

(1) Diameter 1 1/4 inches.
 (2) Total Depth 189 feet.
 (3) Water Level 10' feet below top of ground.
 (4) Cased to _____, Size _____
 (5) Screen: Size 1 1/4, Length 5'
 (6) Were any formations sealed against pollution?
 _____ yes, _____ no.

If YES depth of formation _____
 Why _____

Drillers Remarks: _____

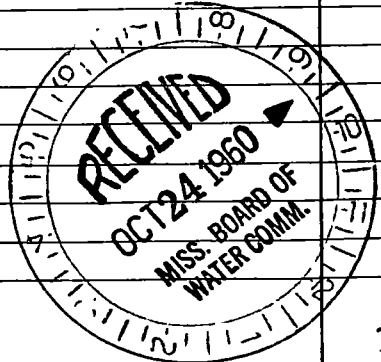

(Use Back Side)

Well No. 11

