

JACKSON
 P 252
 7-67
 4 Q

MISSISSIPPI
 BOARD OF WATER COMMISSIONERS
 416 North State Street
 Jackson, Mississippi 39201

WATER WELL DRILLERS LOG

7-27 1967 Coast Water Well Dr. Jackson
 date well completed firm name County well located

LANDOWNER: Hercules Fishing Club

description of formations encountered	from	to
Red Clay	0	18
Fine Sand	18	37
Blue Clay	37	63
Sand and gravel	63	119
Blue Clay shale	119	139
Sand fine gravel with traces of shell	139	305
Blue Clay shale	305	381
Sand and gravel	381	409


Dartier Miss.
 (mailing address)

WELL LOCATION:
 sec. 8 T. 7 N. R. 6 E. S. W.
 1/2 miles North of Dartier
 (distance) (direction) (nearest town)

WELL PURPOSE: Camp
 (home, irrigation, municipal, industrial)

WELL COMPLETION DATA:

- (1) diameter (inches) 2
- (2) total depth (feet) 409
- (3) static water level (feet) 10 below top of ground.
- (4) casing galv 399 (material) (depth)
 2 (size) telescope see back.
- (5) screen 10' 399 (length) (depth to top)
 2" Standley Wagon (size) (material)
- (6) pump 1 1/2 20 (HP) (yield gpm)
 Elect (type power)
- (7) electric log NO (yes or no)
 (organization running log)
- (8) how well bottom plugged Back wash valve

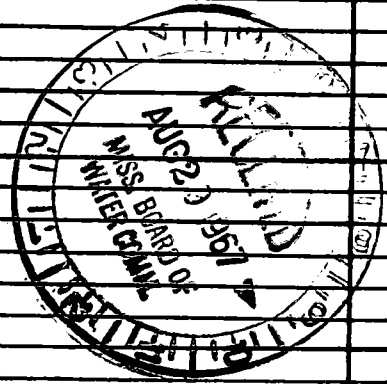


DRILLERS REMARKS:

If well telescopes please sketch and show depths.

GROUND LEVEL

SE NE

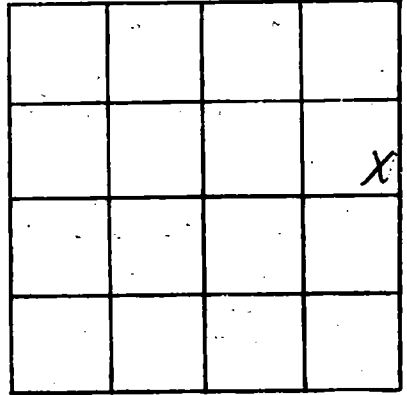

SECTION 8

Please indicate well location X.

ADDITIONAL INFORMATION

If more than one screen, show locations of each on sketch.