

JACKSON
 P 256
 4-68.

MISSISSIPPI
 BOARD OF WATER COMMISSIONERS
 416 North State Street
 Jackson, Mississippi 39201

WATER WELL DRILLERS LOG

4-18-68 19 COAST WATER WELL SER. JACKSON
 date well completed firm name county well located

LANDOWNER: Phil WARE
 801 WASHINGTON AVE.
 Pascagoula, Miss
 (mailing address)

description of formations encountered	from to	
	feet	feet
LOAMY SILL & BLUE CLAY	0	17
FINE SAND	17	19
BLUE-GRAY CLAY	19	37
COARSE SAND & GRAVEL	37	105

WELL LOCATION:
 sec. 14 T. 8 N R. 6 E
 City miles City of Pascagoula
 (distance) (direction) (nearest town)

WELL PURPOSE: drinking (flowers)
 (home, irrigation, municipal, industrial)

- WELL COMPLETION DATA:
- (1) diameter (inches) 2"
 - (2) total depth (feet) 105'
 - (3) static water level (feet) 10' below top of ground.
 - (4) casing GALV. 95'
 (material) (depth)
2" if telescope see back.
 (size)
 - (5) screen 10 ft. 95'
 (length) (depth to top)
2' STAIN. STEEL
 (size) (material)
 - (6) pump 1 1/2 20
 (HP) (yield gpm)
220 volts electricity
 (type power)
 - (7) electric log NO
 (yes or no)

(organization running log)

(8) how well bottom plugged 2" BACK WASH VALVE


DRILLERS REMARKS:

MAY 17 1968

MISS. BD. OF
 WATER COMM.

If well telescopes please sketch and show depths.

GROUND LEVEL

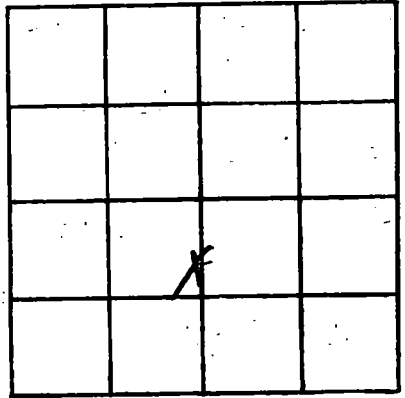

SECTION *14*

Please indicate well location X.

ADDITIONAL INFORMATION

If more than one screen, show locations of each on sketch.