

JACKSON
 P: 58
 7-68

MISSISSIPPI
 BOARD OF WATER COMMISSIONERS
 416 North State Street
 Jackson, Mississippi 39201

WATER WELL DRILLERS LOG

July 10 1964 Colville Water Supply Jackson
 date well completed firm name county well located

LANDOWNER: Frank

Lucas

Gautier, Miss
 (mailing address)

WELL LOCATION:

sec 7 T 7 N R 6 E
 3 1/3 miles NW of Bayou La Batre
 (distance) (direction) (nearest town)

WELL PURPOSE: home
 (home, irrigation, municipal, industrial)

WELL COMPLETION DATA:

- (1) diameter (inches) 2"
- (2) total depth (feet) 112
- (3) static water level (feet) 26 ^{below} _{above} top of ground.
- (4) casing 2" (material), 107 (depth)
- (5) screen 5 (length), 107 (depth to top)
 2" (size), Brass (material)
- (6) pump (HP) (yield gpm)
 (type power)
- (7) electric log no (yes or no)
 (organization running log)
- (8) how well bottom plugged B.P. Kelly

description of formations encountered

from to

Clay	0	25
shand	25	34
Clay	34	105
sand	105	112


DRILLERS REMARKS:

Pump installed by owner

MAY 27 1968
 MISS. BOARD OF
 WATER COMM.

If well telescopes please sketch and show depths.

GROUND LEVEL

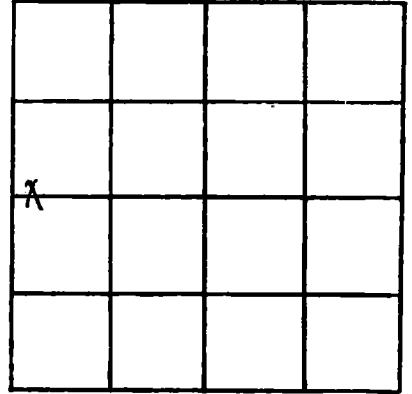

SECTION 7

Please indicate well location X.

ADDITIONAL INFORMATION

If more than one screen,
show locations of each on sketch.