

JACKSON
P. 8-64

MISSISSIPPI
BOARD OF WATER COMMISSIONERS
416 North State Street
Jackson, Mississippi 39201

WATER WELL DRILLERS LOG

Aug 26 1964 Cobville Water Supply Jackson
date well completed firm name county well located

LANDOWNER: Alvin
Charlton
Passagoula, Miss
(mailing address)
WELL LOCATION:
sec. 3 T 7 N R 6 E
1/4 miles north of Joe
(distance) (direction) (nearest town)

description of formations encountered	from	to
Clay	0	10
Sand	10	66
Clay	86	125
sand	125	166
Clay	166	387
Sand	387	412

WELL PURPOSE: Drain
(home, irrigation, municipal, industrial)


WELL COMPLETION DATA:
(1) diameter (inches) 1 1/4
(2) total depth (feet) 412
(3) static water level (feet) 5 below above top of ground.
(4) casing Cable 404
(material) (depth)
(size) If telescope see back.
(5) screen 8' 404
(length) (depth to top)
1 1/4 Copper Gauge
(size) (material)
(6) pump _____ (HP) _____ (yield gpm)
(type power)
(7) electric log no
(yes or no)
(organization running log)
(8) how well bottom plugged B.P. Valley

MAY 27 1968
MISS. BOARD OF
WATER COMM.

DRILLERS REMARKS: young ind. by owner

If well telescopes please sketch and show depths.

GROUND LEVEL

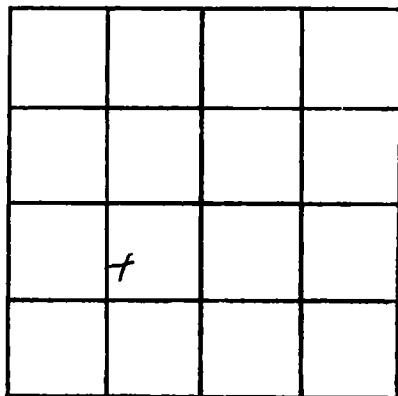

SECTION 3

Please indicate well location X.

ADDITIONAL INFORMATION

If more than one screen,
show locations of each on sketch.